


# DRIVEWAY PROFILE HORIZONTAL SCALE: 1" = 10' VERTICAL SCALE: 1" = 5'

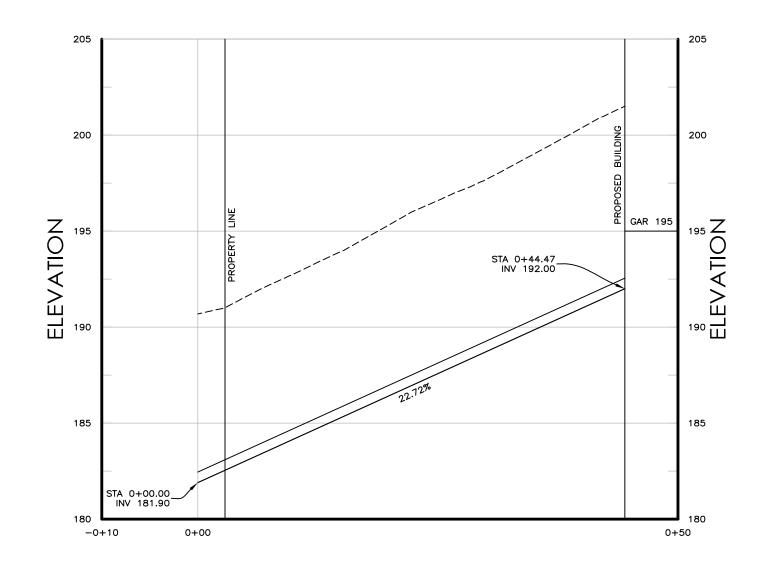


# SANITARY SEWER SERVICE PROFILE HORIZONTAL SCALE: 1" = 10' VERTICAL SCALE: 1" = 5'

	<u>Z</u>	ONING TABLE	
ZONE: ONE-FAM		MILY RESIDENCE I	DISTRICT ZONE 'R-5'
MINIMUM REQUIREMENTS		REQUIRED	<u>PROPOSED</u>
LOT AREAS (SF)		5,000 SF	15,577.8 SF
LOT AREA (ACRES)		0.1148 ACRES	0.3576 ACRES
LOT WIDTH (FEET)		50 FT	106.6 FT
LOT DEPTH (FEET)		80 FT	160.5 FT
FRONT YARD (FEET)		25 FT	39.7 FT
ONE SIDE YARD (FEET)		8 FT	18.0. FT
BOTH SIDE YARDS (FEET)		18 FT	59.5 FT
REAR YARD (FEET)		26 FT	63.0 FT
MAXIMUM PERMITTED		<u>PERMITTED</u>	PROPOSED
BUILDING HEIGHT (STORIES)		2.5	2.5
BUILDING HEIGHT (FEET)		35 FT	28.58 FT
BUILDING COVERAGE (PERCENT)		30%	10.4%

ESIGN STORM (25 YR.): YDROLOGIC SOIL TYPE:	in.	
HYDROLOGIC SOIL TYPE:	The state of the s	6.46
		В
EXISTING CN:		55
PROPOSED CN:		98
REQUIRED STORAGE VOLUME CALCULATION		
EX. RUNOFF DEPTH:	in.	1.79
PR. RUNOFF DEPTH:	in.	6.22
DELTA RUNOFF DEPTH:	in.	4.43
REQUIRED STORAGE VOLUME:	c.f.	1155.0
DRYWELL INFORMATION		
LENGTH OF 1 CHAMBER:	ft.	8.5
WIDTH OF 1 CHAMBER:	ft.	4.33
HEIGHT OF CHAMBER:	ft.	2.54
WIDTH OF STONE SURROUNDING CHAMBER:	ft.	1
DEPTH OF STONE UNDER CHAMBER:	ft.	0.5
STONE VOID RATIO:		0.33
VOLUME PER DRYWELL (AS PER MANUFACTURER):	c.f./l.f.	7.46
TRENCH SIZE		
TRENCH WIDTH:	ft.	6.33
TRENCH LENGTH (UNIT LENGTH):	ft.	1
TRENCH HEIGHT:	ft.	3.04
TRENCH VOLUME:	c.f./l.f.	19.24
STONE VOID VOLUME:	c.f.	3.89
PERCOLATION AREA:	s.f./l.f.	6.33
PERCOLATION RATE: *ESTIMATED*	* min./in.	15
PERCOLATION HOLE DIAMETER:	in.	10
WATER LEVEL DROP	in.	1
AVERAGE DEPTH OF WATER	in.	8.5
PERCOLATION HOLE BOTTOM AREA:	s.f.	0.55
PERCOLATION HOLE SIDE AREA:	s.f.	1.85
PERCOLATION HOLE TOTAL AREA:	s.f.	2.40
PERCOLATION VOLUME CHANGE	c.f.	0.045
ADJUSTED PERCOLATION RATE:	c.f./s.f./day	1.82
PERCOLATION VOL. PER DAY:	c.f./day/l.f.	11.5
SOIL CLOGGING FACTOR:		25%
PERCOLATION WITH CLOGGING:	c.f./day/l.f.	8.6
TOTAL VOLUME OF CHAMBERS:	c.f./day/l.f.	20.0
REQUIRED LENGTH CHAMBERS:	L.F.	57.81
REQUIRED NUMBER OF CHAMBERS	EA.	9

INFILTRATOR SYSTEM WILL BE REVISED AS NECESSARY.

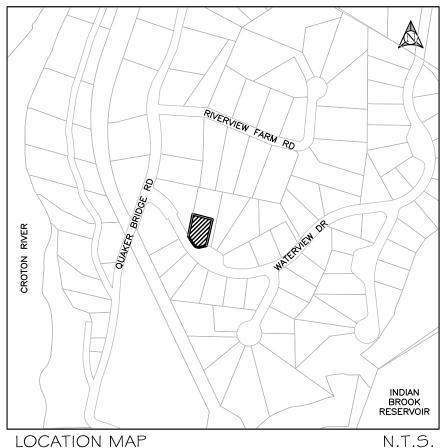

LOCATION MAP

1. CONTRACTOR SHALL BE RESPONSIBLE FOR COMPLIANCE WITH ALL SEDIMENT AND EROSION CONTROL PRACTICES. THE SEDIMENT AND EROSION CONTROL PRACTICES ARE TO BE INSTALLED PRIOR TO ANY MAJOR SOIL DISTURBANCES, AND MAINTAINED IN EFFECTIVE CONDITION THROUGHOUT THE CONSTRUCTION PERIOD OR UNTIL PERMANENT PROTECTION IS ESTABLISHED. 2. PRIOR TO ANY EXCAVATION, SILT FENCE SHALL BE INSTALLED AT THE LOCATIONS NOTED ON THE EROSION CONTROL PLAN. ADDITIONAL SILT FENCE MAY BE REQUIRED BY THE ENGINEER IN THE FIELD. SILT FENCING SHALL BE MAINTAINED IN EFFECTIVE CONDITION AND SHALL NOT BE REMOVED UNTIL DISTURBED AREAS ARE THOROUGHLY STABILIZED.

3. INSTALL ANTI-TRACKING PAD AT ALL CONSTRUCTION ENTRANCES. ANTI-TRACKING PAD SHALL BE 2"-3" DIAMETER CRUSHED STONE 6" DEEP.

4. TIMELY MAINTENANCE OF SEDIMENT CONTROL STRUCTURES IS THE RESPONSIBILITY OF THE CONTRACTOR. ALL STRUCTURES SHALL BE MAINTAINED IN GOOD WORKING ORDER AT ALL TIMES. THE SEDIMENT LEVEL IN ALL SEDIMENT REMOVING DEVICES SHALL BE CLOSELY MONITORED AND SEDIMENT REMOVED PROMPTLY WHEN MAXIMUM LEVELS ARE REACHED OR AS ORDERED BY THE ENGINEER. SEDIMENT SHALL BE DISPOSED OF IN A MANNER THAT DOES NOT RESULT IN ADDITIONAL EROSION OR POLLUTION. ALL SEDIMENT CONTROL STRUCTURES SHALL BE INSPECTED ON A REGULAR BASIS, AND IMMEDIATELY AFTER EACH RAINFALL TO INSURE PROPER OPERATION AS DESIGNED. ANY REQUIRED REPAIRS SHALL BE MADE IMMEDIATELY.

5. ALL TOPSOIL NOT TO BE USED FOR FINAL GRADING SHALL BE REMOVED FROM THE SITE IMMEDIATELY AND PLACED IN A STABILIZED STOCKPILE OR FILL AREA. ALL TOPSOIL REQUIRED FOR FINAL GRADING AND STORED ON SITE SHALL BE LIMED, FERTILIZED, TEMPORARILY SEEDED AND MULCHED WITHIN 14 DAYS OR OTHERWISE STABILIZED. DO NOT STOCKPILE MATERIALS ON STEEP SLOPES, IN DRAINAGE SWALES OR IN WETLAND AREAS. SURROUND ALL STOCKPILE AREAS WITH STAKED HAYBALES OR SILT FENCE.

6. ALL SLOPES CONSTRUCTED WITH FILL MATERIAL AND ALL SLOPES WITH GRADE 3:1 OR STEEPER SHALL BE TOPSOILED, SEEDED, MULCHED AND STABILIZED WITH STAKED TOBACCO NETTING, OR EROSION BLANKET AS NOTED, UNLESS OTHERWISE DIRECTED. 7. ANY DISTURBED AREAS THAT WILL BE LEFT EXPOSED MORE THAN 14 DAYS AND NOT SUBJECT TO CONSTRUCTION TRAFFIC, SHALL IMMEDIATELY RECEIVE TEMPORARY SEEDING. MULCH SHALL BE USED IF THE SEASON PREVENTS THE ESTABLISHMENT OF A TEMPORARY COVER. DISTURBED AREAS SHALL BE LIMED AND FERTILIZED PRIOR TO TEMPORARY SEEDING. 8. ALL DISTURBED AREAS WITHIN 500 FEET OF A BUILDING SHALL BE WETTED AS NECESSARY TO PROVIDE DUST CONTROL. A WATERING TRUCK WILL BE USED IN DRY SEASON TO WET DOWN DUST AREAS. 9. THE CONTRACTOR SHALL KEEP THE ROADWAYS WITHIN THE PROJECT CLEAR OF SOIL AND DEBRIS AND IS RESPONSIBLE FOR ANY STREET CLEANING NECESSARY DURING THE COURSE OF THE PROJECT. 10. ALL CATCH BASINS AND DRAIN INLETS ARE TO BE PROTECTED WITH SEDIMENT FILTERS THROUGHOUT THE CONSTRUCTION PERIOD AND UNTIL ALL DISTURBED AREAS ARE STABILIZED.


11. UTILITY LINE EXCAVATED MATERIAL SHALL BE TEMPORARILY STOCKPILED ON THE HIGH SIDE OF EXCAVATION SO RUNOFF IS DIRECTED AWAY FROM TRENCH. AFTER BACK—FILLING, AREA IS TO BE TOPSOILED, SEEDED AND MULCHED. 12. SEDIMENT AND EROSION CONTROL STRUCTURES SHALL BE REMOVED AND THE AREA STABILIZED WHEN THE DRAINAGE AREA HAS BEEN PROPERLY STABILIZED BY PERMANENT MEASURES.

13. ALL AREAS OF DISTURBED SOIL SHALL BE STABILIZED BY THE CONTRACTOR. IN ADDITION TO ALL SPECIFIED EROSION CONTROL DEVICES, THE CONTRACTOR SHALL TAKE ALL STEPS PRUDENT AND NECESSARY TO STABILIZE THE SITE AT ALL TIMES. 14. ALL SEDIMENT AND EROSION CONTROL MEASURES SHALL BE INSTALLED IN ACCORDANCE WITH THE CURRENT EDITION OF "NEW YORK STATE STANDARDS AND

SPECIFICATIONS FOR EROSION AND SEDIMENT CONTROLS" (BLUE BOOK).



IT IS A VIOLATION OF THE NEW YORK STATE EDUCATION LAW, ARTICLE 145, SECTION 7209(2), FOR ANY PERSON, UNLESS HE IS ACTING UNDER THE DIRECTION OF A LICENSED PROFESSIONAL ENGINEER OR LAND SURVEYOR, TO ALTER ANY ITEM ON THIS PLAN IN ANY WAY. IF ANY ITEM BEARING THE SEAL OF AN ENGINEER OR LAND SURVEYOR IS ALTERED, THE ALTERING ENGINEER OR LAND SURVEYOR SHALL AFFIX TO THE ITEM HIS SEAL AND THE NOTATION "ALTERED BY" FOLLOWED BY HIS SIGNATURE AND THE DATE OF SUCH ALTERATION, AND A SPECIFIC DESCRIPTION OF THE ALTERATION.

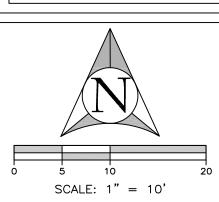



ALFONZETTI ENGINEERING, P.C. 1100 ROUTE 52, CARMEL, N.Y. 10512 845 - 228 - 9800


SITE DATA OWNER/APPLICANT: POLZELLA CONSTRUCTION CORP. SITE ADDRESS: 3 WATERVIEW DR. OSSINING, NY 10562 TAX MAP #: 80.10-1-9 LOT AREA: 0.3576 ACRES ZONING: R-5


REVISED: OCTOBER 8, 2020 REVISED: SEPTEMBER 2, 2020

SITE PLAN MAY 29, 2020

POLZELLA RESIDENCE

TOWN OF OSSINING, WESTCHESTER COUNTY, NEW YORK

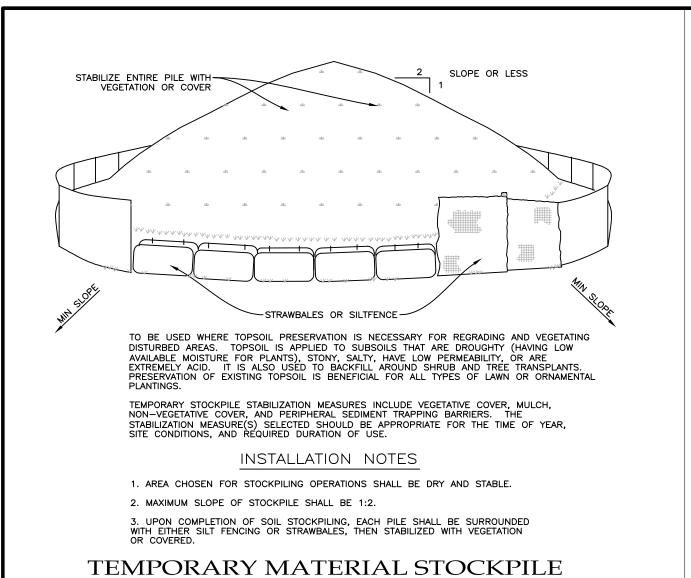

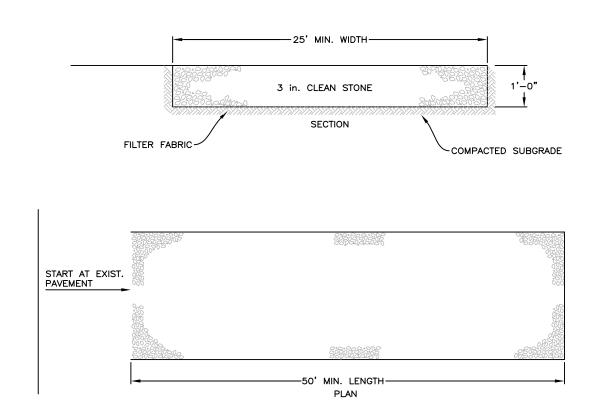

TO BE PROVIDED AT ALL POINTS OF EQUIPMENT INGRESS OR EGRESS ONTO PUBLIC RIGHTS-OF-WAY.

INSTALLATION NOTES

1. STONE SIZE - USE 3" STONE, OR RECLAIMED OR RECYCLED CONCRETE EQUIVALENT.

2. LENGTH - AS REQUIRED, BUT NOT LESS THAN 50 FEET (EXCEPT ON A SINGLE RESIDENCE LOT WHERE A 30 FOOT MINIMUM LENGTH WOULD APPLY.

3. THICKNESS - NOT LESS THAN SIX (6) INCHES.

4. WIDTH - 25 FOOT MINIMUM, BUT NOT LESS THAN THE FULL WIDTH AT POINTS WHERE INGRESS OR EGRESS OCCUR.

5. FILTER CLOTH - WILL BE PLACED OVER THE ENTIRE AREA PRIOR TO PLACING OF STONE. FILTER CLOTH WILL NOT BE REQUIRED ON A SINGLE FAMILY RESIDENCE LOT.


6. SURFACE WATER - ALL SURFACE WATER FLOWING OR DIVERTED TOWARD CONSTRUCTION ENTRANCES SHALL BE PIPED ACROSS THE ENTRANCE. IF PIPING IS IMPRACTICAL, A MOUNTABLE BERM WITH 5:1 SLOPES WILL BE PERMITTED.

7. MAINTENANCE - THE ENTRANCE SHALL BE MAINTAINED IN A CONDITION WHICH WILL PREVENT TRACKING OR FLOWING OF SEDIMENT ONTO PUBLIC RIGHT OF WAY THIS MAY REQUIRE PERIODIC TOP DRESSING WITH ADDITIONAL STONE AS CONDITIONS DEMAND AND REPAIR AND/OR CLEANOUT OF ANY MEASURES USED TO TRAP SEDIMENT. ALL SEDIMENT SPILLED, DROPPED, WASHED OR TRACKED ONTO PUBLIC RIGHT OF WAY MUST BE REMOVED IMMEDIATELY.


8. WASHING — WHEELS SHALL BE CLEANED TO REMOVE SEDIMENT PRIOR TO ENTRANCE ONTO PUBLIC RIGHT OF WAY. WHEN WASHING IS REQUIRED, IT SHALL BE DONE ON AN AREA STABILIZED WITH STONE AND WHICH DRAINS INTO AN APPROVED SEDIMENT TRAPPING DEVICE.


9. PERIODIC INSPECTION AND NEEDED MAINTENANCE SHALL BE PROVIDED AFTER EACH RAIN.


STABILIZED CONSTRUCTION ENTRANCE (ANTI-TRACKING PAD)

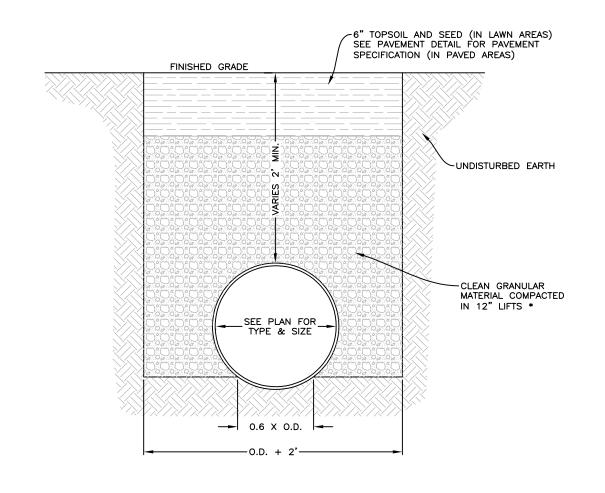


DRAIN PIPE TRENCH DETAIL N.T.S.

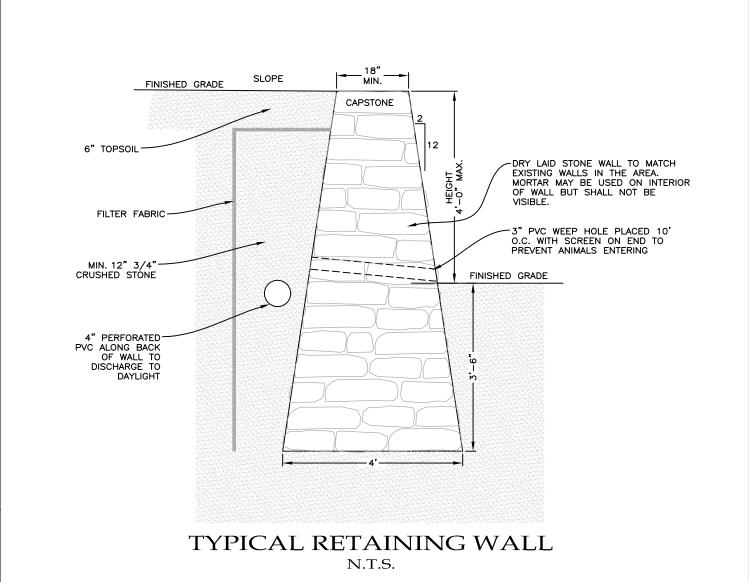


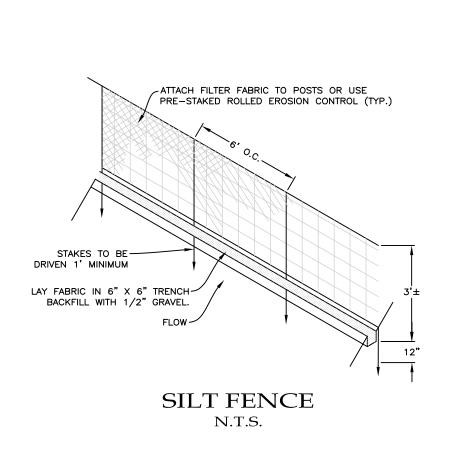


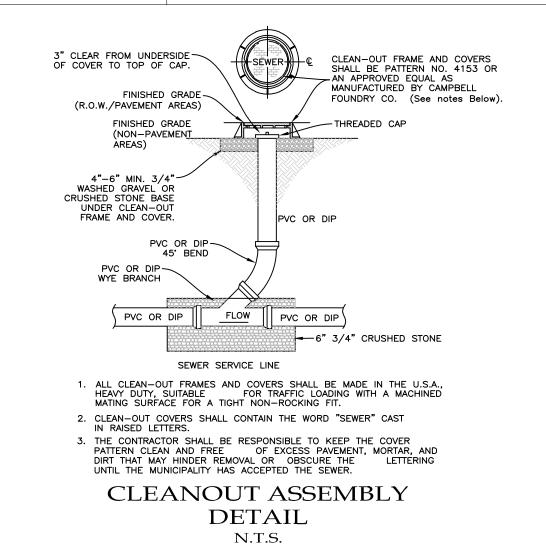

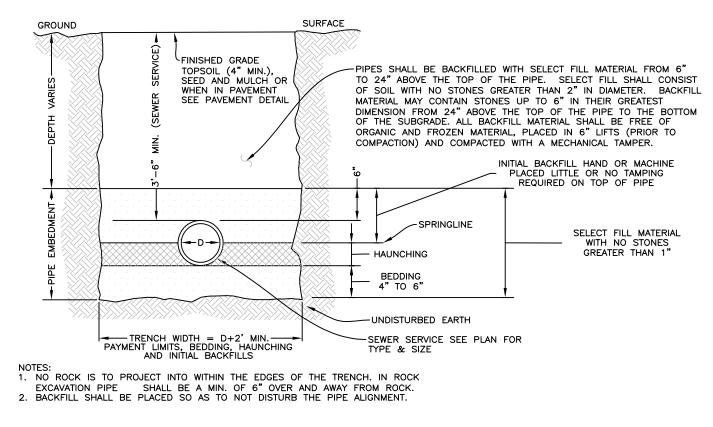




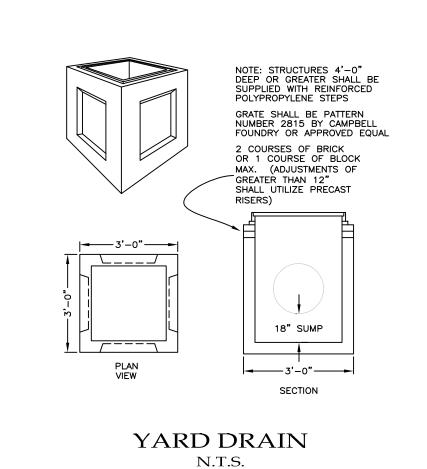


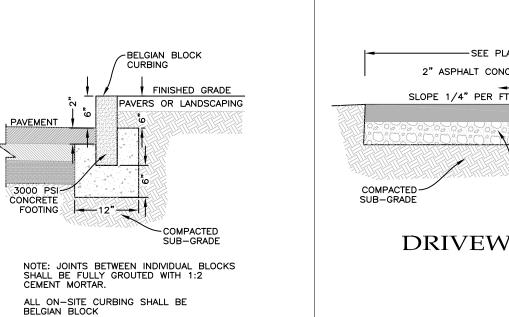

BELGIAN BLOCK CURB

N.T.S.

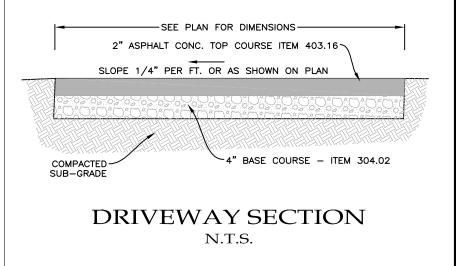

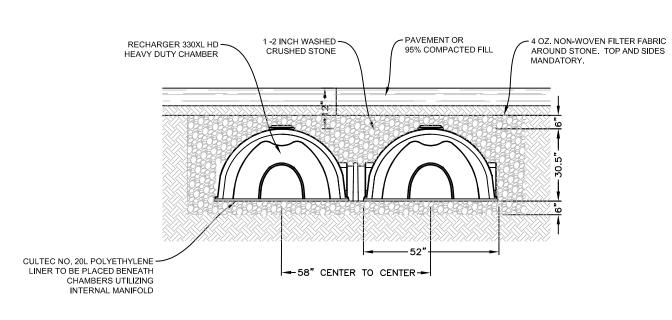

GENERAL NOTES

RECHARGER 330XL HD BY CULTEC, INC. OF
BROOKFIELD, CT.

STORAGE PROVIDED = 11.32 CF/FT PER DESIGN
UNIT.

REFER TO CULTEC, INC.'S CURRENT
RECOMMENDED INSTALLATION GUIDELINES.
USE RECHARGER 330XL HD HEAVY DUTY FOR
TRAFFIC AND/OR H-25 APPLICATIONS.


ALL RECHARGER 330XL HD HEAVY DUTY
FOR DESIGN
UNITS ARE MARKED WITH A COLOR STRIPE
FORMED INTO THE PART ALONG THE
LENGTH OF THE CHAMBER.
ALL RECHARGER 330XL HD HEAVY DUTY
FOR THE PART ALONG THE
LENGTH OF THE CHAMBERS
MUST BE INSTALLED IN ACCORDANCE WITH
ALL APPLICABLE LOCAL, STATE AND
FEDERAL REGULATIONS.

CHAMBERS SHALL BE INSTALLED AS PER MANUFACTURER'S RECOMMENDATIONS

CHAMBERS SHALL BE INSTALLED AS PER MANUFACTURER'S RECOMMENDATIONS

STORMWATER CHAMBER CROSS SECTION


N.T.S.

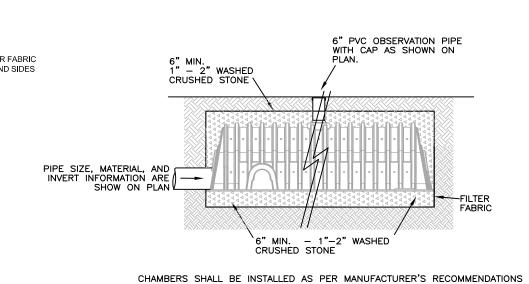


ALL RECHARGER 330XL HD HEAVY DUTY UNITS ARE MARKED WITH A COLOR STRIPE FORMED INTO THE PART ALONG THE LENGTH OF THE CHAMBER.
ALL RECHARGER 330XL HD CHAMBERS MUST BE INSTALLED IN ACCORDANCE WITH ALL APPLICABLE LOCAL, STATE AND FEDERAL REGULATIONS.

GENERAL NOTES
RECHARGER 330XL HD BY CULTEC, INC. OF BROOKFIELD,
CT.
STORAGE PROVIDED = 11.32 CF/FT PER DESIGN UNIT.
REFER TO CULTEC, INC.'S CURRENT RECOMMENDED
INSTALLATION GUIDELINES. USE RECHARGER 330XL HD
HEAVY DUTY FOR TRAFFIC AND/OR H-25 APPLICATIONS.


STORMWATER CHAMBER INSTALLATION N.T.S.

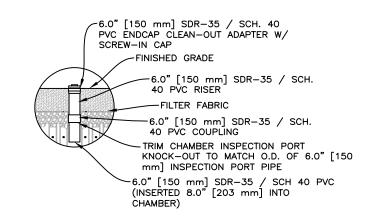

'CULTEC' CHAMBERS INSPECTION PORT NON-TRAFFIC APPLICATION N.T.S

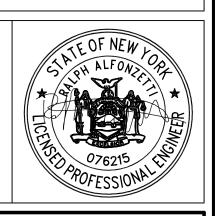


ALFONZETTI ENGINEERING, P.C. 1100 ROUTE 52, CARMEL, N.Y. 10512 845 - 228 - 9800

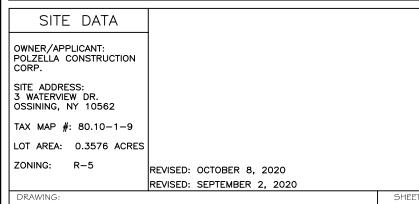

SITE PLAN MAY 29, 2020


POLZELLA RESIDENCE
TOWN OF OSSINING,
WESTCHESTER COUNTY, NEW YORK

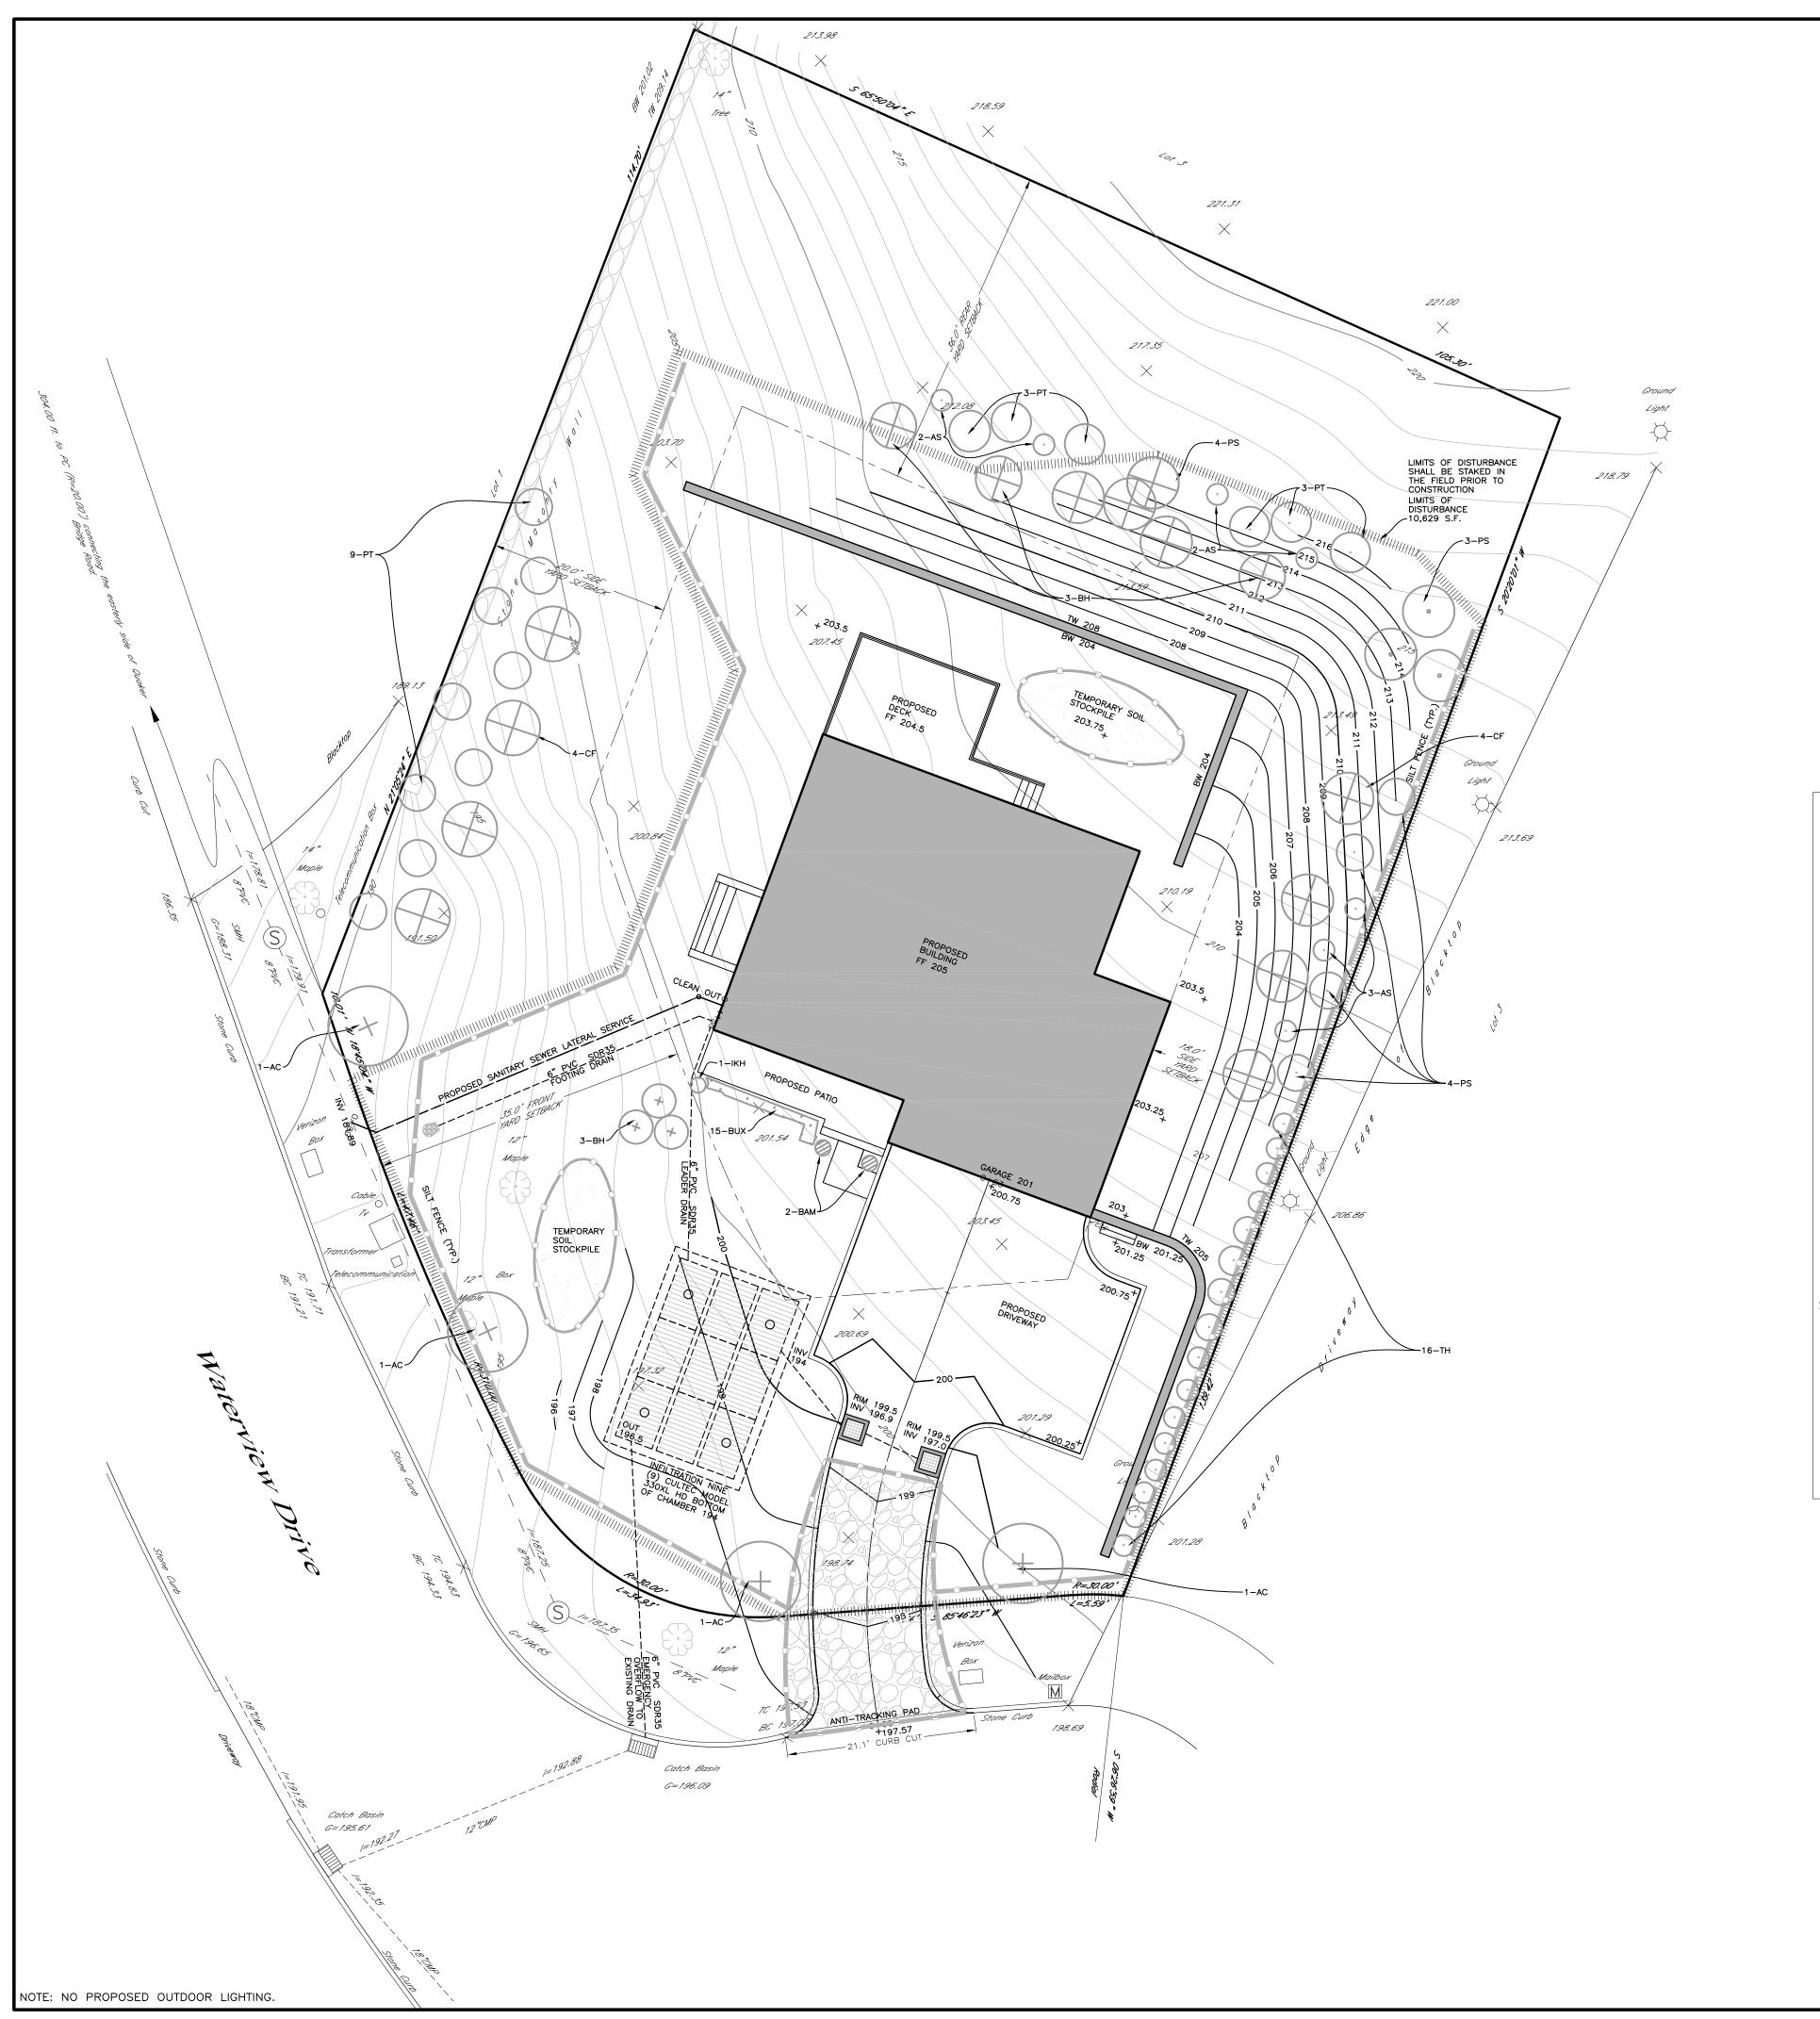


REVISED PLANT SCHEDULE QUAN. BOTANICAL / COMMON NAME SIZE TREES 3"-31/2" Cal. Acer rubrum "October Glory" Betula "Heritage" — Heritage Birch, three stems 10'-12' HT. Cornus florida — Flowering dogwood 8'-10' HT. 7'-8' HT. Pinus strobus — Eastern White Pine PT Picea abies — Norway Spruce 7'-8' HT. Thuja p."Green Giant" — Northern Cedar 5'-6' HT. 3"-31/2" Cal. Acer saccharum "Sugar Maple" SHRUBS: Buxus "Green Gem" 18"-24" HT. BUX Buxus "Green Mountain" (not conical) 30"-36" HT. llex x "Keohneana" (Not Nelli Stevens) specimen 5'-6' HT. All planting beds shall be mulched with 3" of shredded hardwood bark, such as pine bark, (as recommended by the Morton Arboretum).


None of the plants listed are on any NYS invasive species list.


LANDSCAPING INFORMATION AS PER FRANK GIULIANO, LANDSCAPE ARCHITECT.

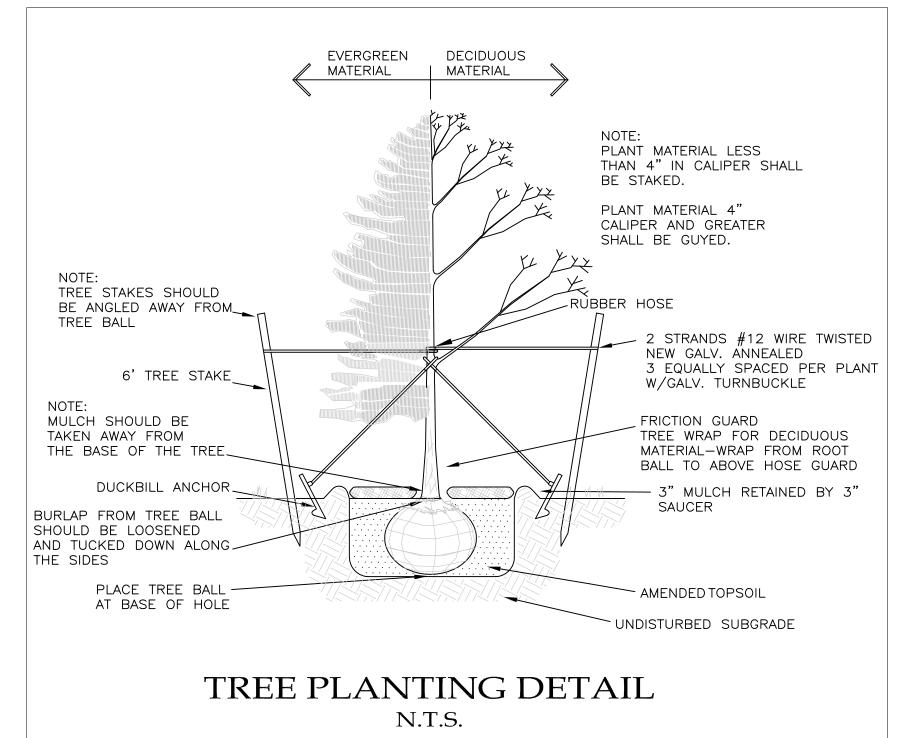

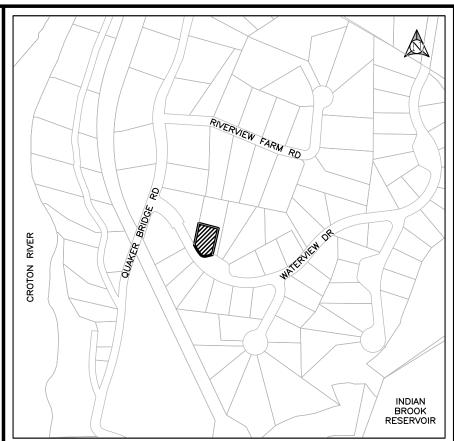

LOCATION MAP N.T.S.

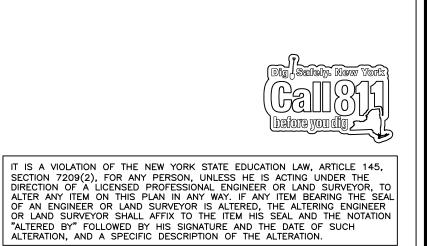

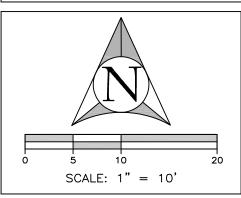



ALFONZETTI ENGINEERING, P.C. 1100 ROUTE 52, CARMEL, N.Y. 10512 845 - 228 - 9800

SITE DATA

OWNER/APPLICANT:
POLZELLA CONSTRUCTION
CORP.

SITE ADDRESS:
3 WATERVIEW DR.
OSSINING, NY 10562

TAX MAP #: 80.10-1-9

LOT AREA: 0.3576 ACRES

ZONING: R-5

REVISED: OCTOBER 8, 2020
REVISED: SEPTEMBER 2, 2020

LANDSCAPING PLAN
AUGUST 12, 2020

POLZELLA RESIDENCE
TOWN OF OSSINING,
WESTCHESTER COUNTY, NEW YORK










1 inch = 70 Feet




August 11, 2020

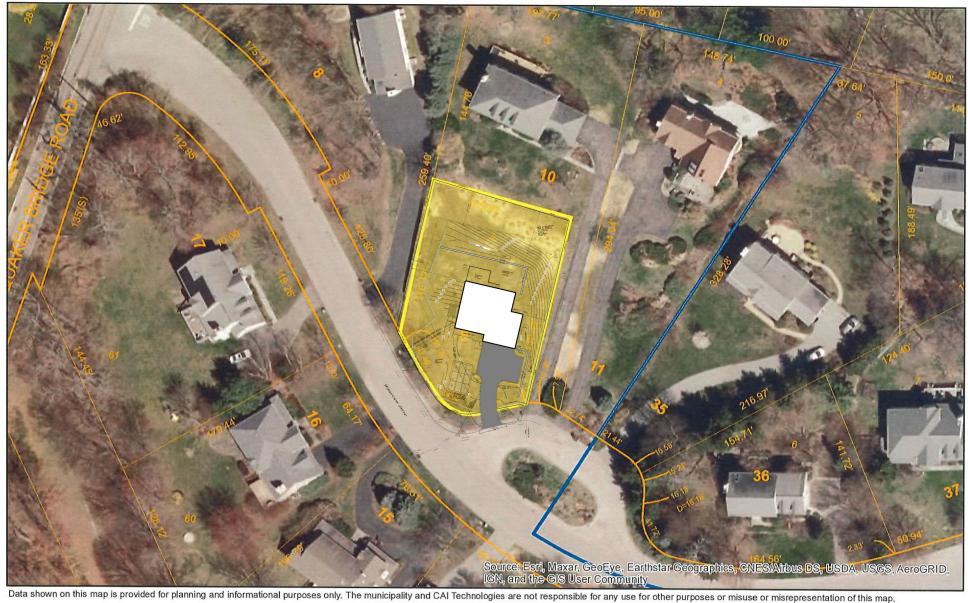

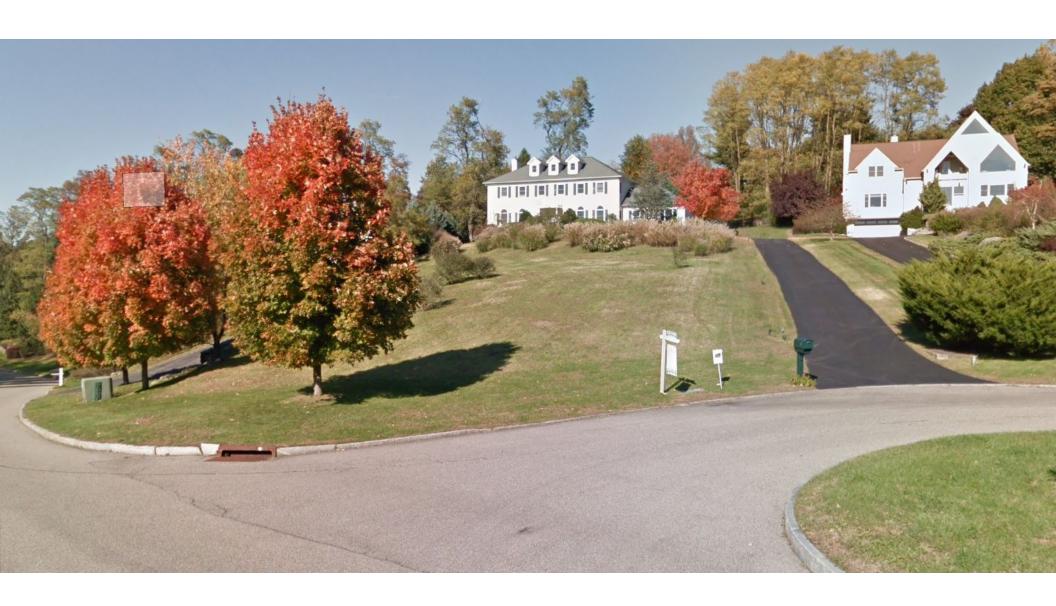


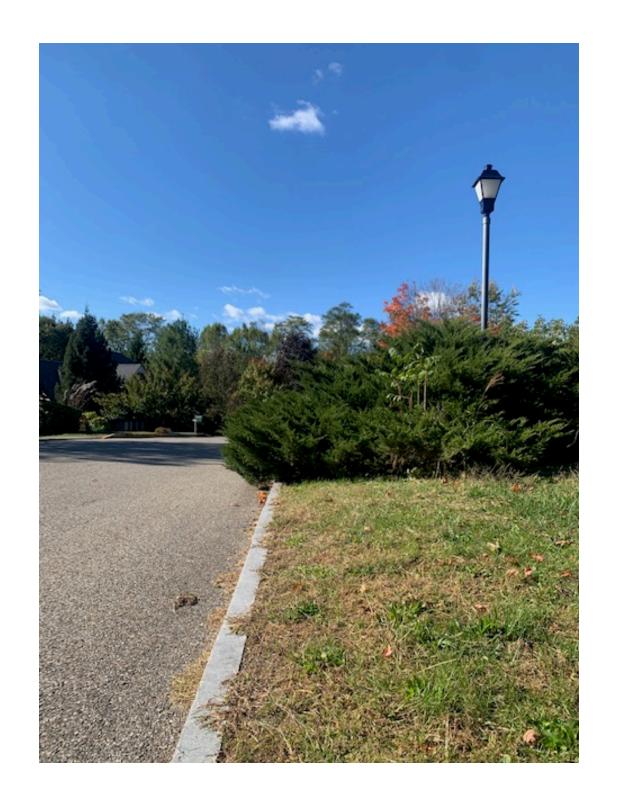



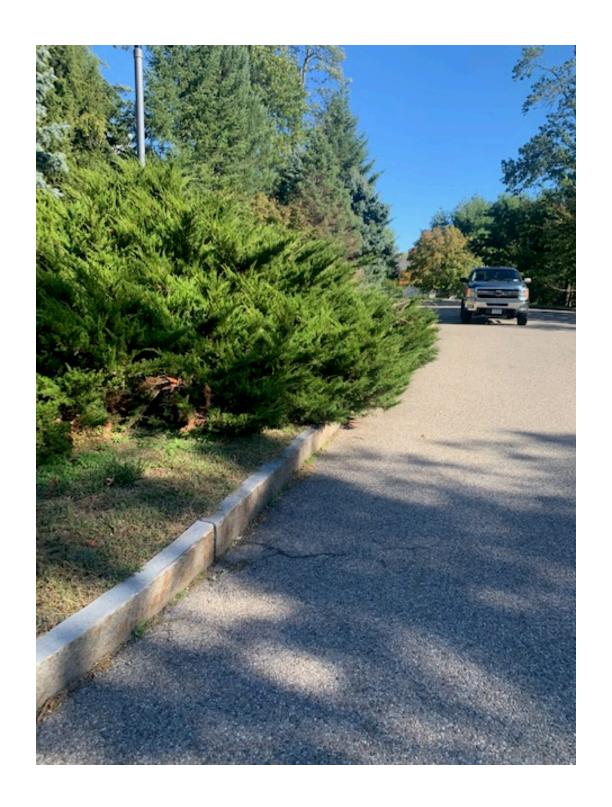





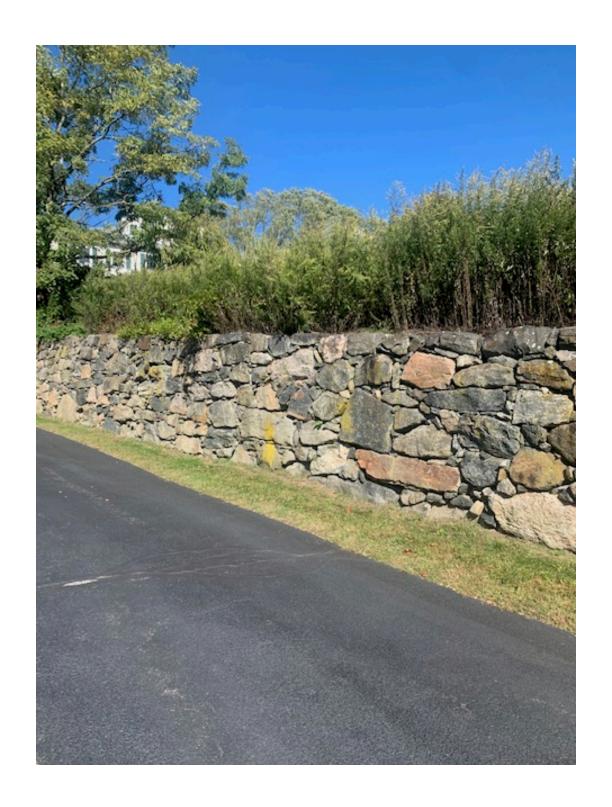



#### Schedule For Proposed Building Material and Color Scheme 2020 Residential Code Of New York State Name: Type: Color: Climatic & Geographic Design Criteria Table R301.2(1) 4 Bevel 5" To Weather Siding: Vinyl Cream Subject To Damage From Winter Weathering Frost Line Design Termite Temp. Ground Snow Load ice Shield Underlayment Required Flood Air Freezing Hazards Index Mean Annual Temperature O Topographic Effects Wind-Borne Special Wind Andersen, 400 Series White Windows: Double Hung Speed (mph) 0 Debris Zone Moderate Vinyl WA White Trim: 42" 30 lb/ft 115 - 120 mph Severe Yes 1500 or Less 52.2 F られば Yes Zone I K15C0, Front Door: Therma-Tru Composite Black Manual J Design Criteria Garage Doors: White Clopay Composite Design Temperature Cooling Heating Temperature Difference Summer Cooling Elevation Latitude Altitude Correction Indoor Design Temperature Heating Factor Roofing: CertainTeed Asphalt Roof Charcoal Gray 7 75 Gutters White Aluminum Cooling Temperature Difference Wind Velocity Wind Velocity Coincident Daily Range Winter Humidity Summer Humidity Heating Cooling Shutters Panel Black **2 2 2** Composite 20.4 7.5 7.5 30 55 SMITH -25/8" Handrail (Style Continuous Ridge Vent To Be Selected) (<del>4</del><del>1</del><del>4</del>) Verify 4" Sphere Cannot 36" Min - | 3/4" Sq Baluster (Style To Be Selected) 27" Min Asphalt Shingles 31 1/2" Min Ix8 Rake w/ Alum. Cover-4 1/2" -3/4" Quarter Round 1x6 Fascia Bd. Vinyl -5 1/4" Base Molding w/ 3/4" Quarter Round Stair / Handrail Minimum Clearances B.E. Alum. Gutter - 2" Cont. Soffit Vent Elevation Plan -5/4 x 4 Wd. Frieze Bd. Top Plate / Ceiling Hgt , Stair Clearance Detail Window Hgt , 0.H.<del>?</del> 4" Crown Molding w/ Copper Drip Cap Flashing 4" Vinyl Corner Bd. - 16" Raised Panel Shutter 🞖 Insulation Note: Vinyl Siding No Soffit Vent, Gable Vent, And Ridge Vent Required With Spray Foam Insulation Metal Roofing Second Floor Hgt Asphalt Shingles New Low Watt Light Fixture (Less Than 2,700k) w/ Motion Sensor Window Hgt, Epoxy Mortor/Grout ₽ 2 5/8" Ext. Plywood Underlayment Over Plywood Subfloor (See Plans) Finish Fir. (See Plans) Maintain 1/4" Gap Between Exterior Grade Plywood Sheets (Top Layer) Fill Gap With Epoxy When Setting Till 9 Residence 12" Dia. HB&G Permacast Column First Floor Hgt NOTE: Refer To Specifications By Manf. And The Tile Council Of America Average Elevation Cross Bridging @ Mid Span ARB 9/24/20 2x Wd. Floor Jsts. (See Floor Plans For Structural Framing) └─Vinyl lattice w/ Wd Frame Retaining Wall as Req'd by Grade Provide 4" Weep Holes e every 4"-0" o.c. Railing As Required 3 11/6" Max. Spacing Between Balusters Overhead Carriage Style Garage Door-Connect to 6" PVC — (Per Engineer's Plan) ARB 8/20/20 -12" Dia. Conc. Pier On 24" Bell Footing w/Hardware Tile Floor Detail (Thin Set) Revision Date Date -20" x 10" Concrete Footing w/(2) #4 Bars Cont. July 22, 2020 Step Footing 1:2 Max -12" Dia. Conc. Pier Basement Floor Hgt On 24" Bell Footing <u>As Required</u> Job No Square Footage 22*0*-011 New Exterior Light Note: Front Elevation Drawing First Floor 1,026 Sf All New Light @ Exterior To Be Low Wattage (Less Than 2,700k) w/ Motion Sensor 1,322 Sf Second Floor Scale: 1/4" = 1'-0" 2,348 Sf Total


Do Not Scale Prints These plans are the property of the Architect. Any use or reproduction in whole or part without the written authorization of the Architect is prohibited. Any person or corporation using plans without proper authorization will be responsible to compensate the Architect is prohibited. Any person or corporation using plans without proper authorization will be responsible to compensate the Architect is prohibited.

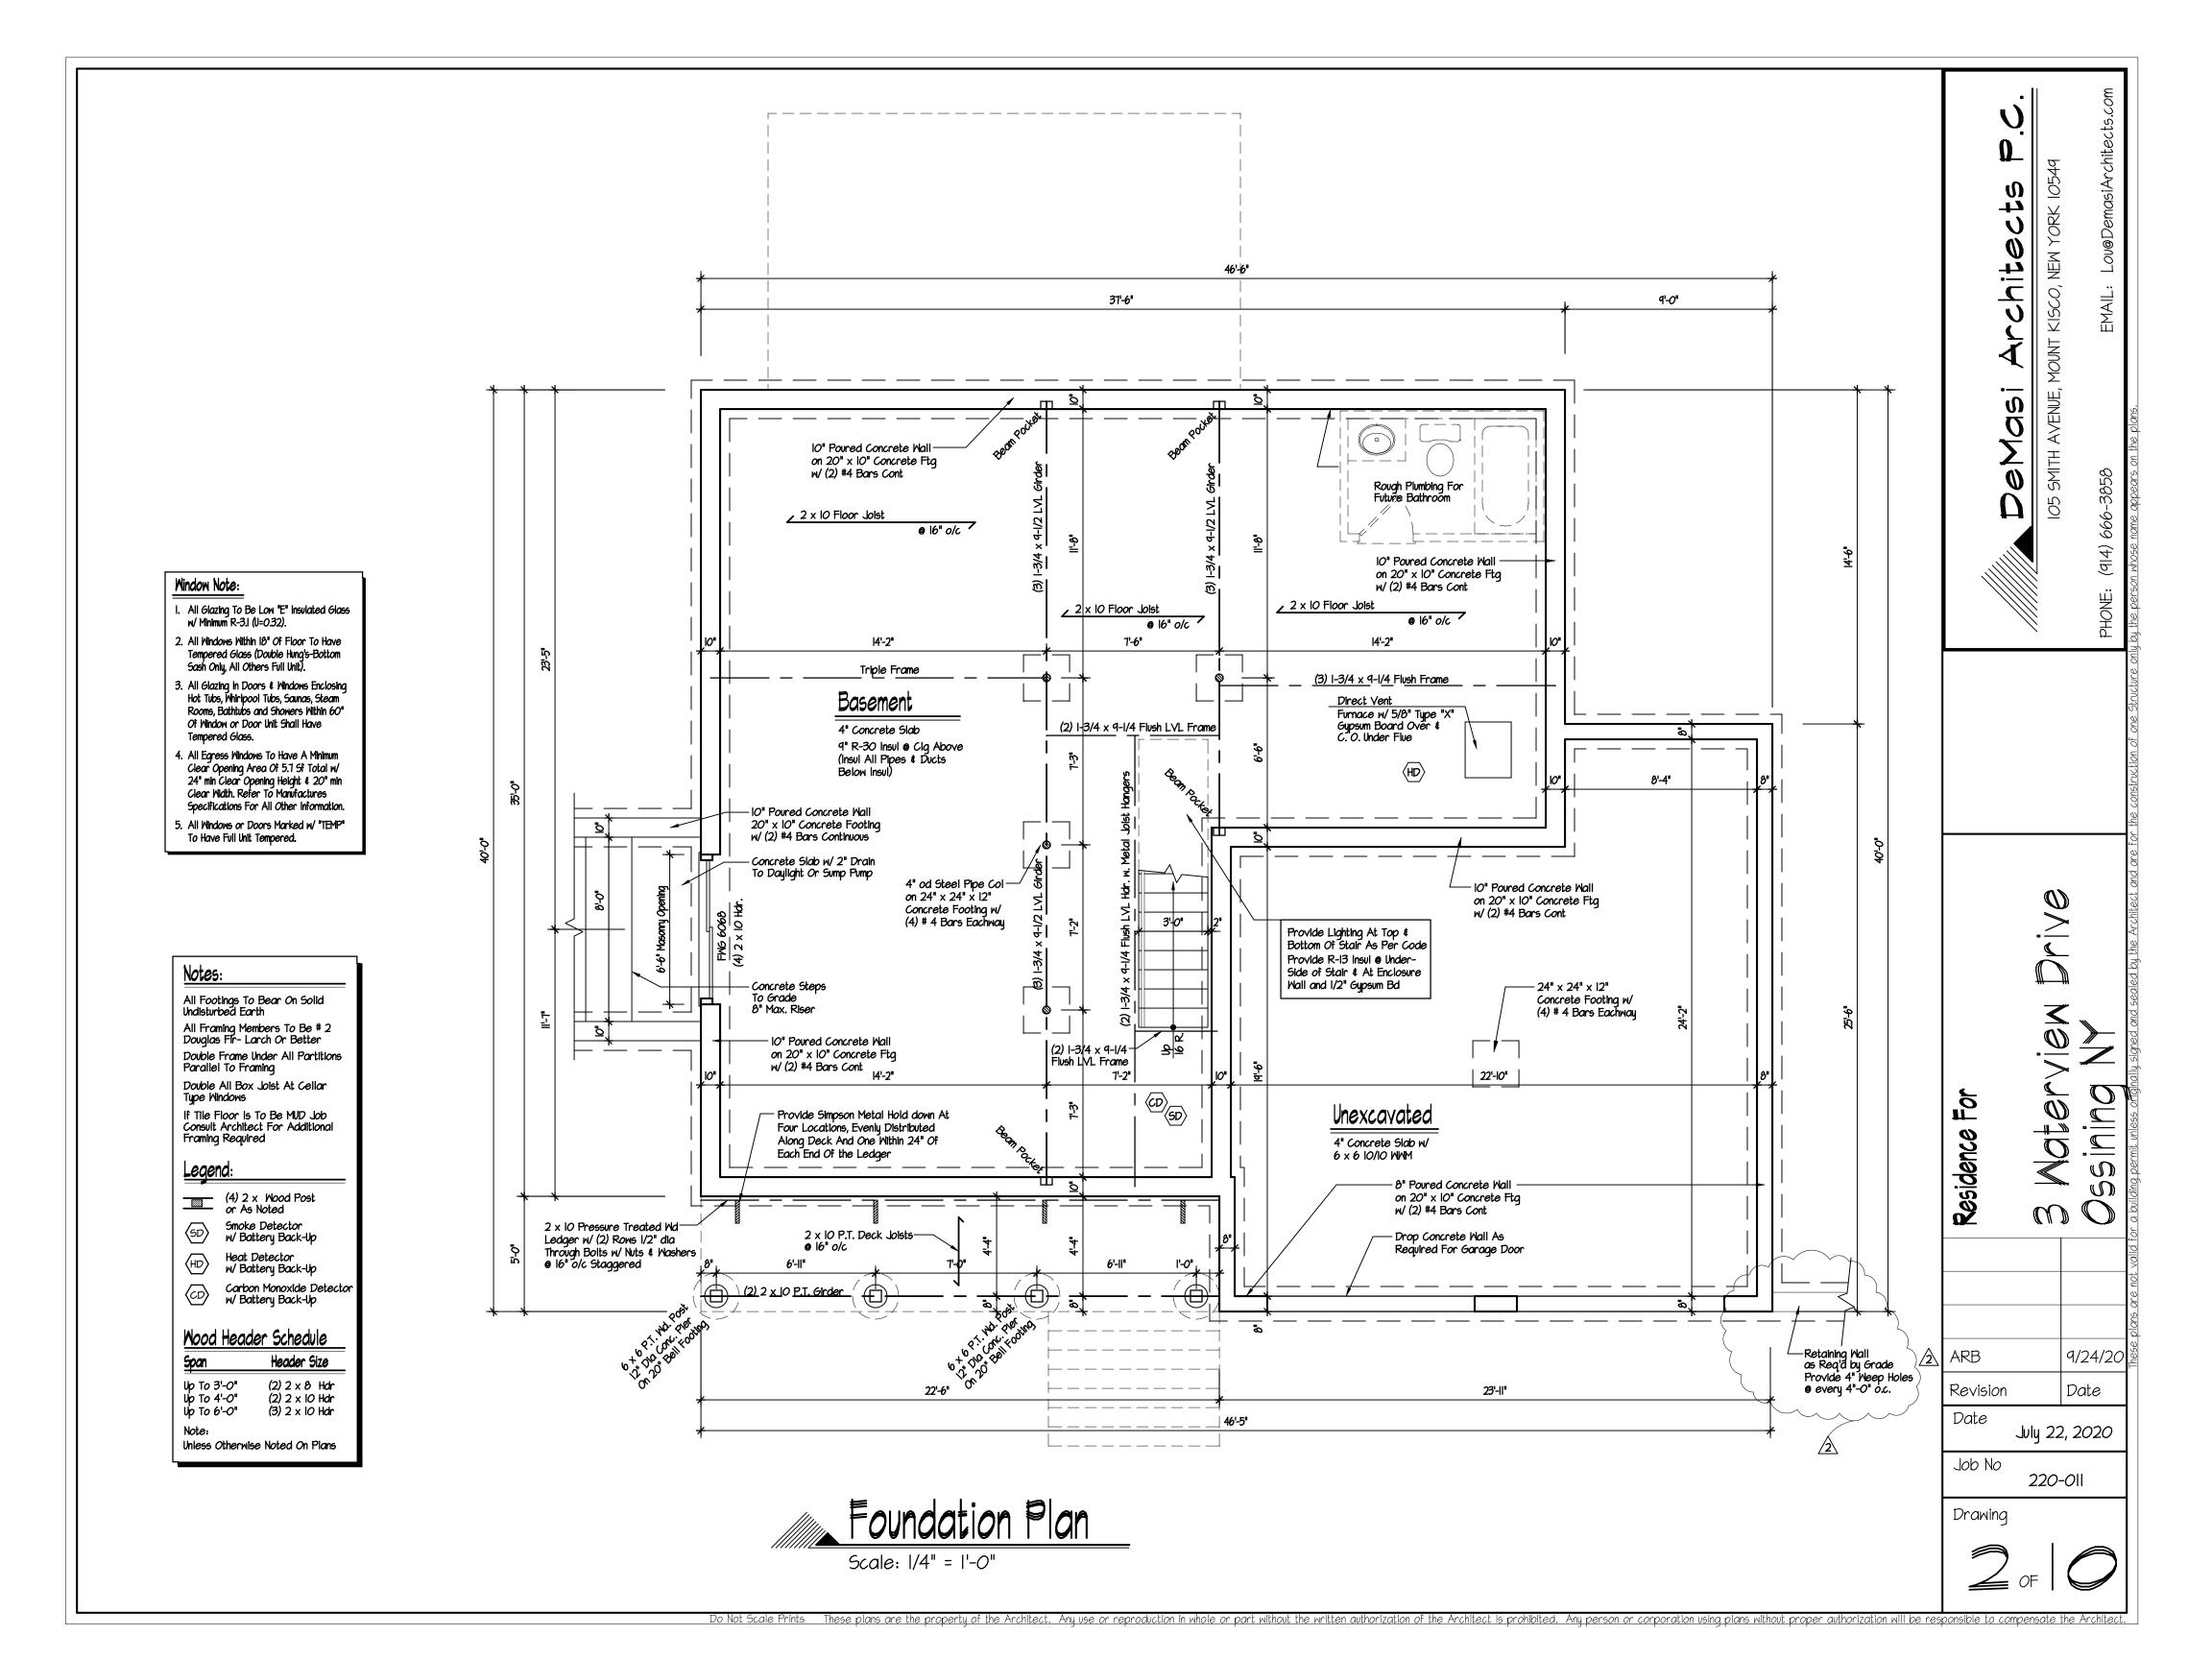


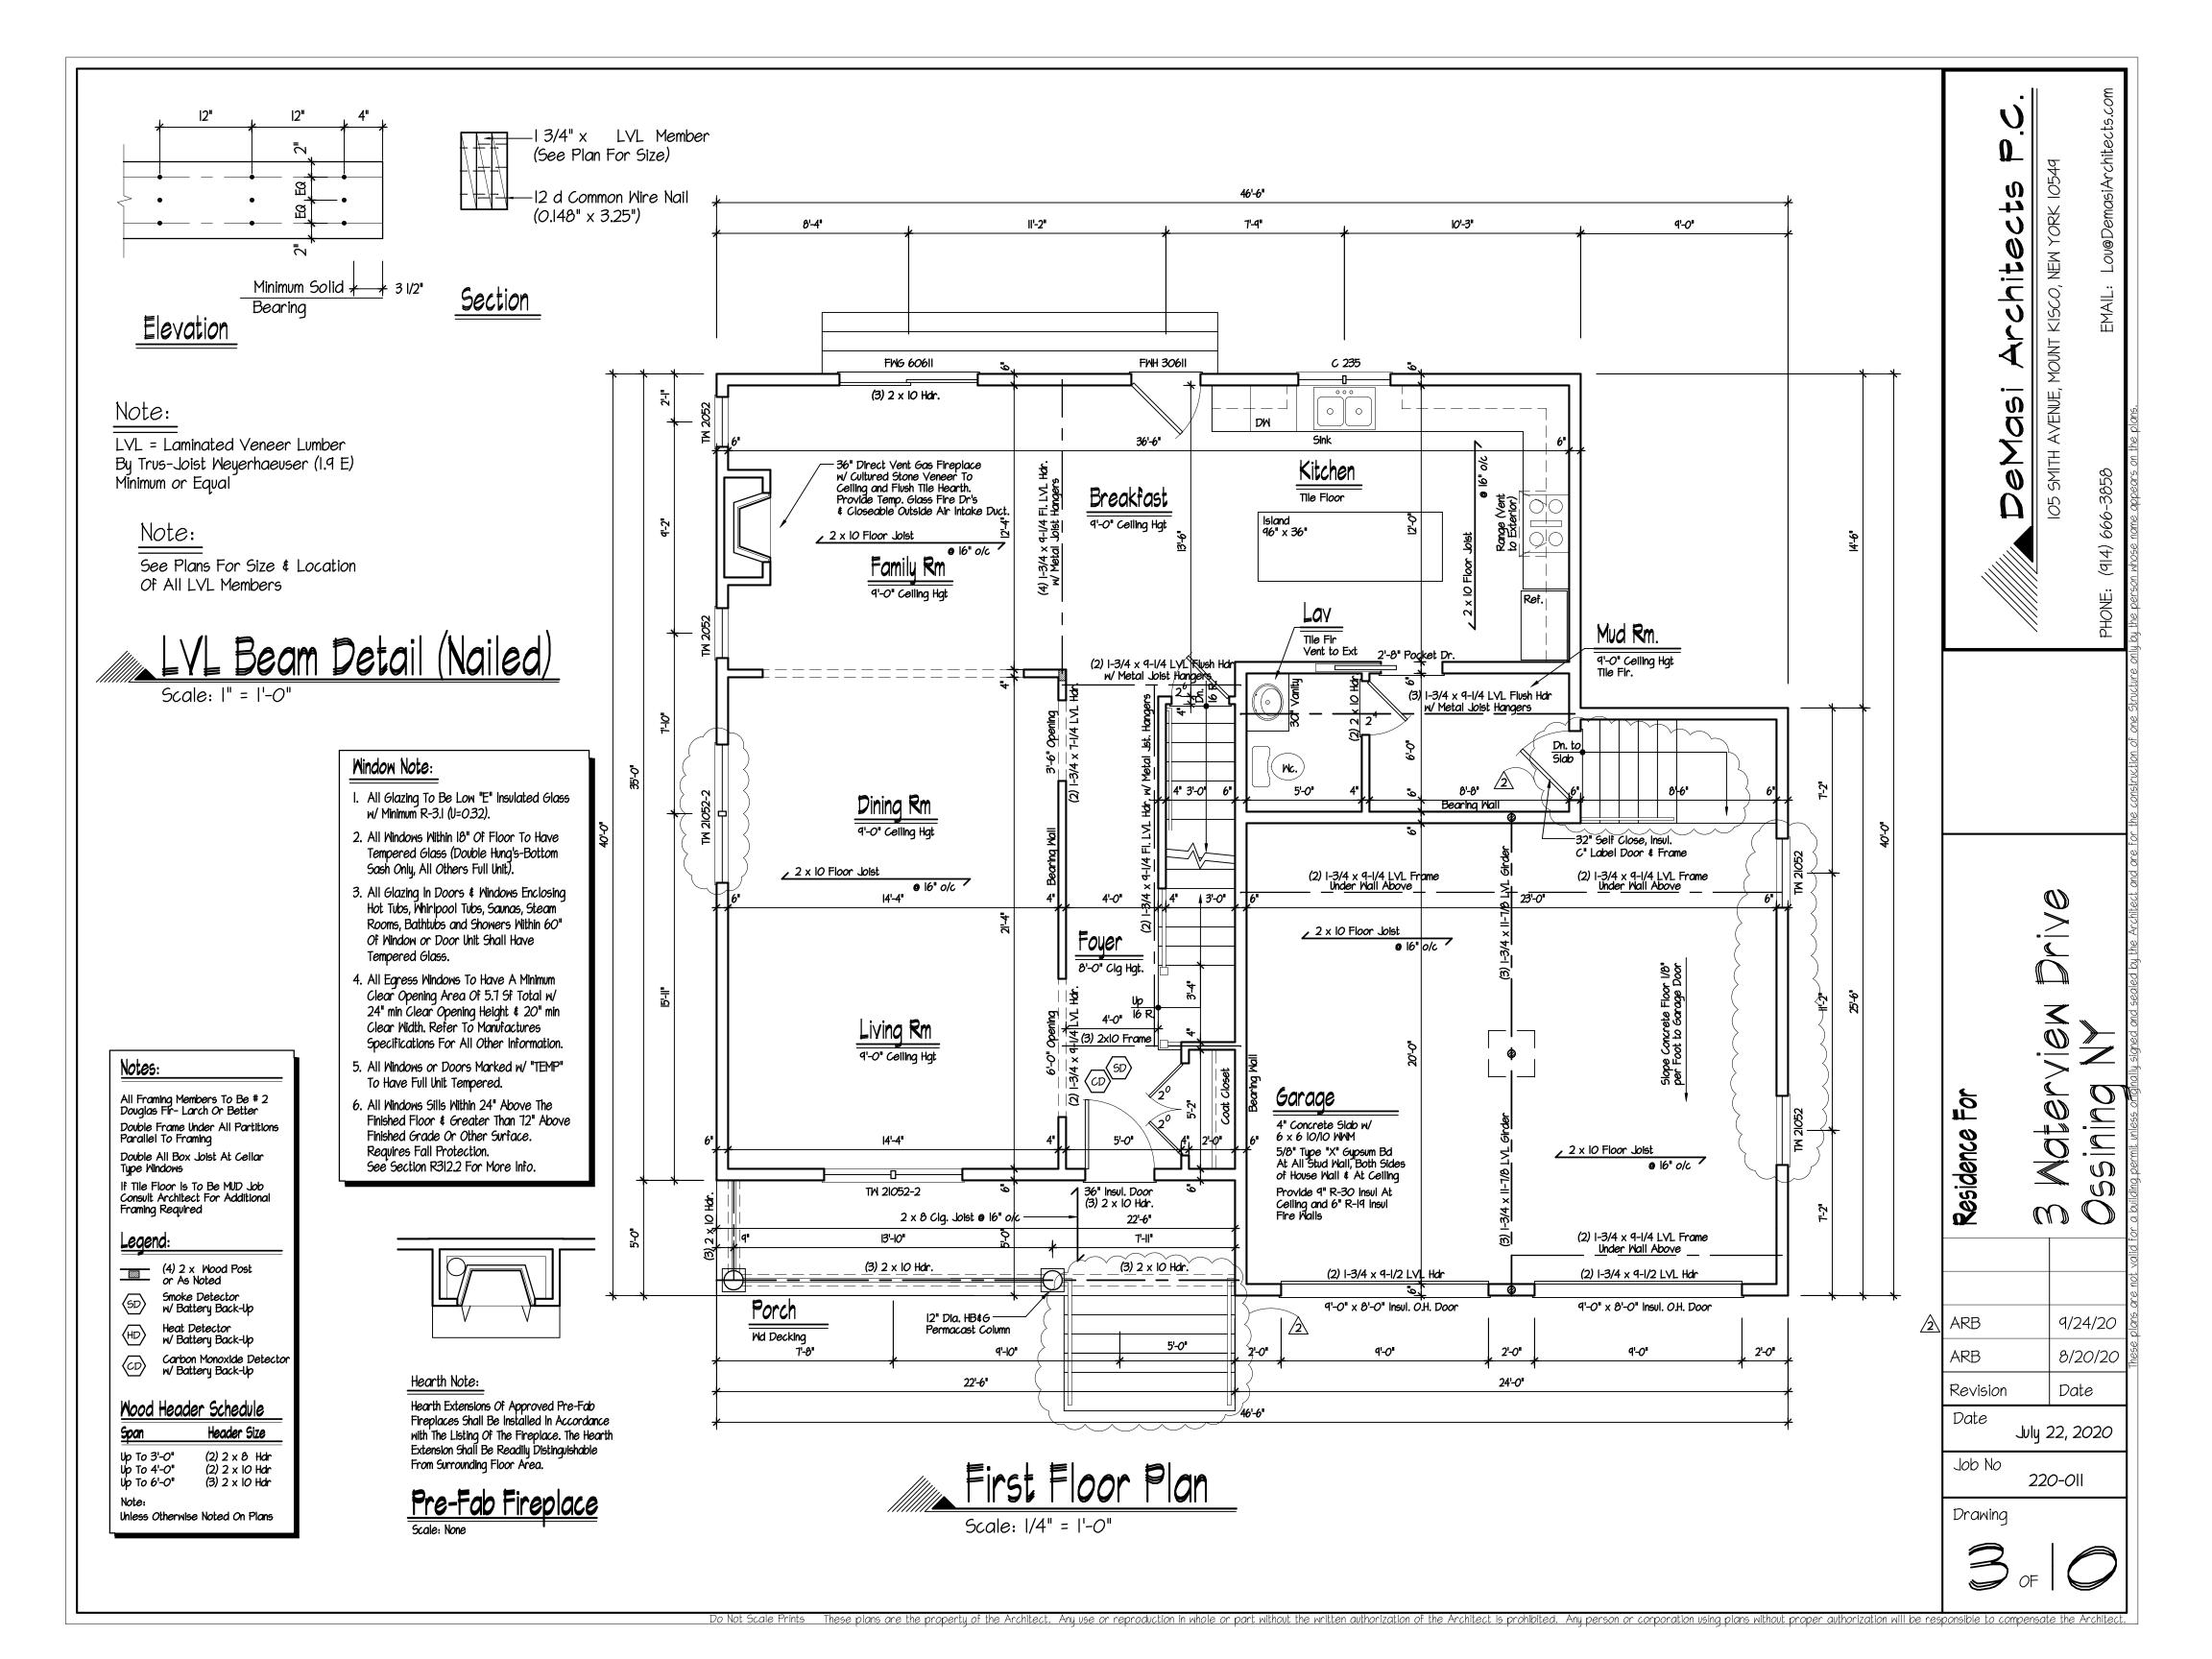


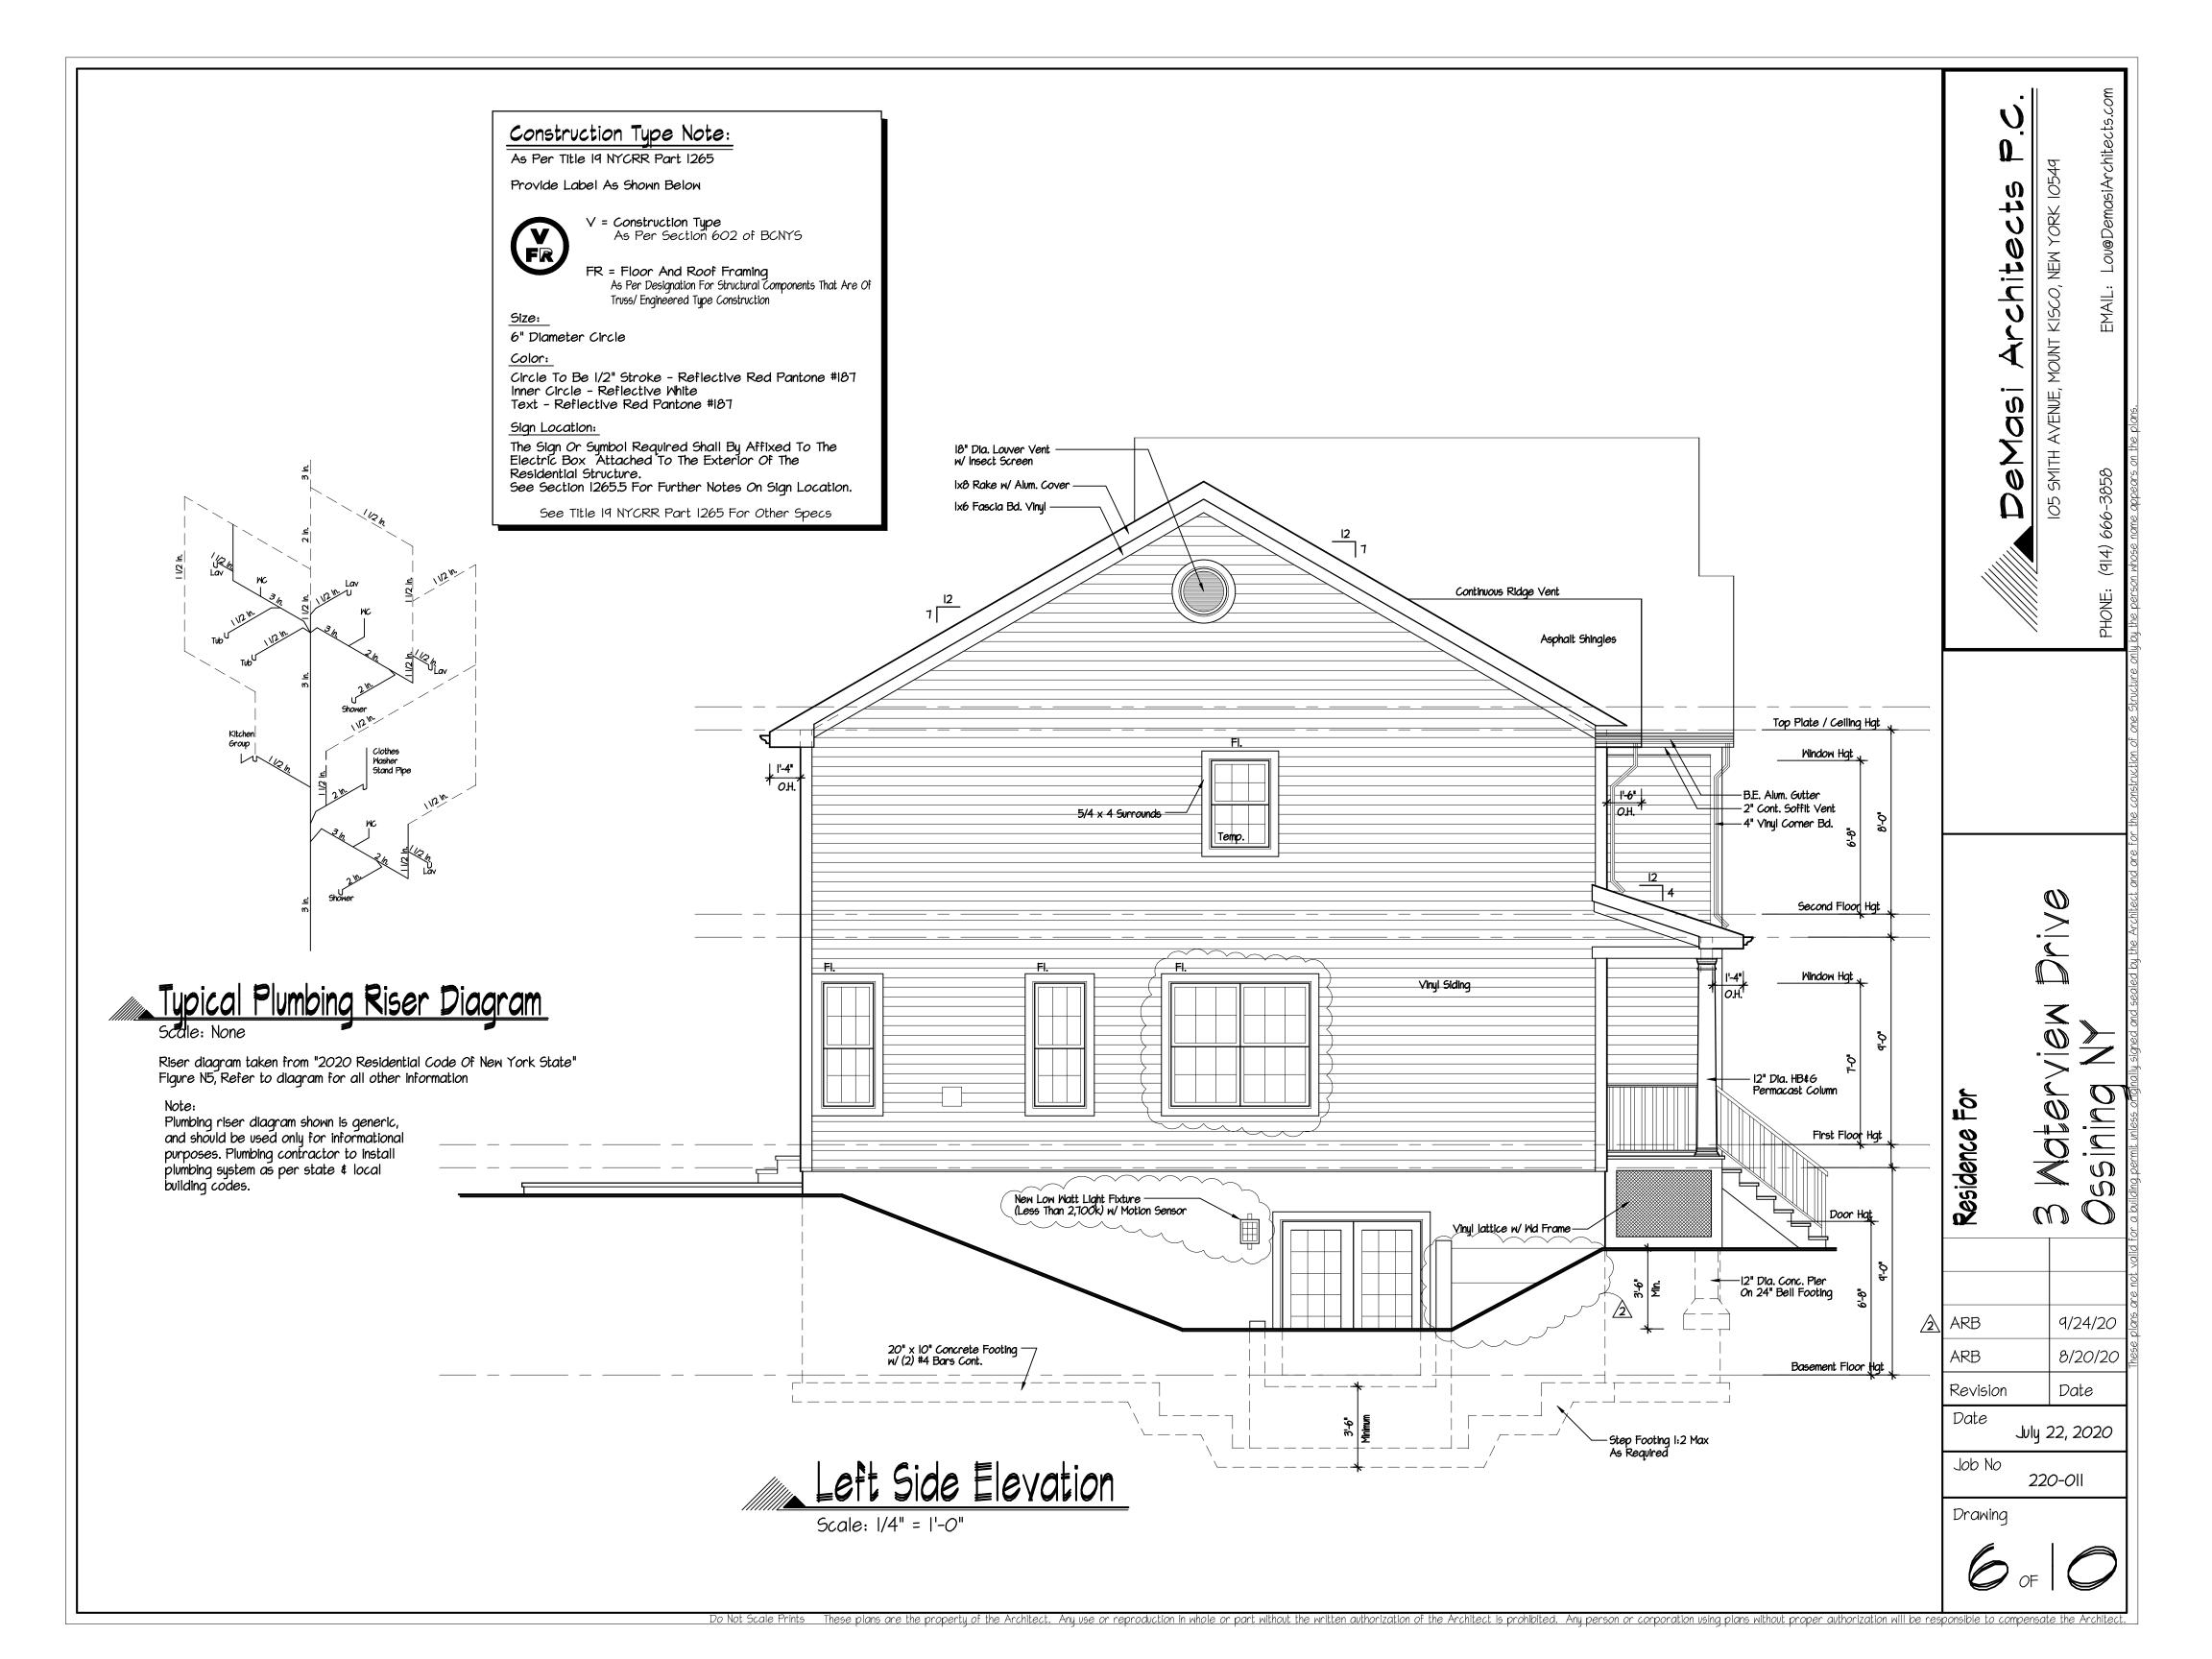

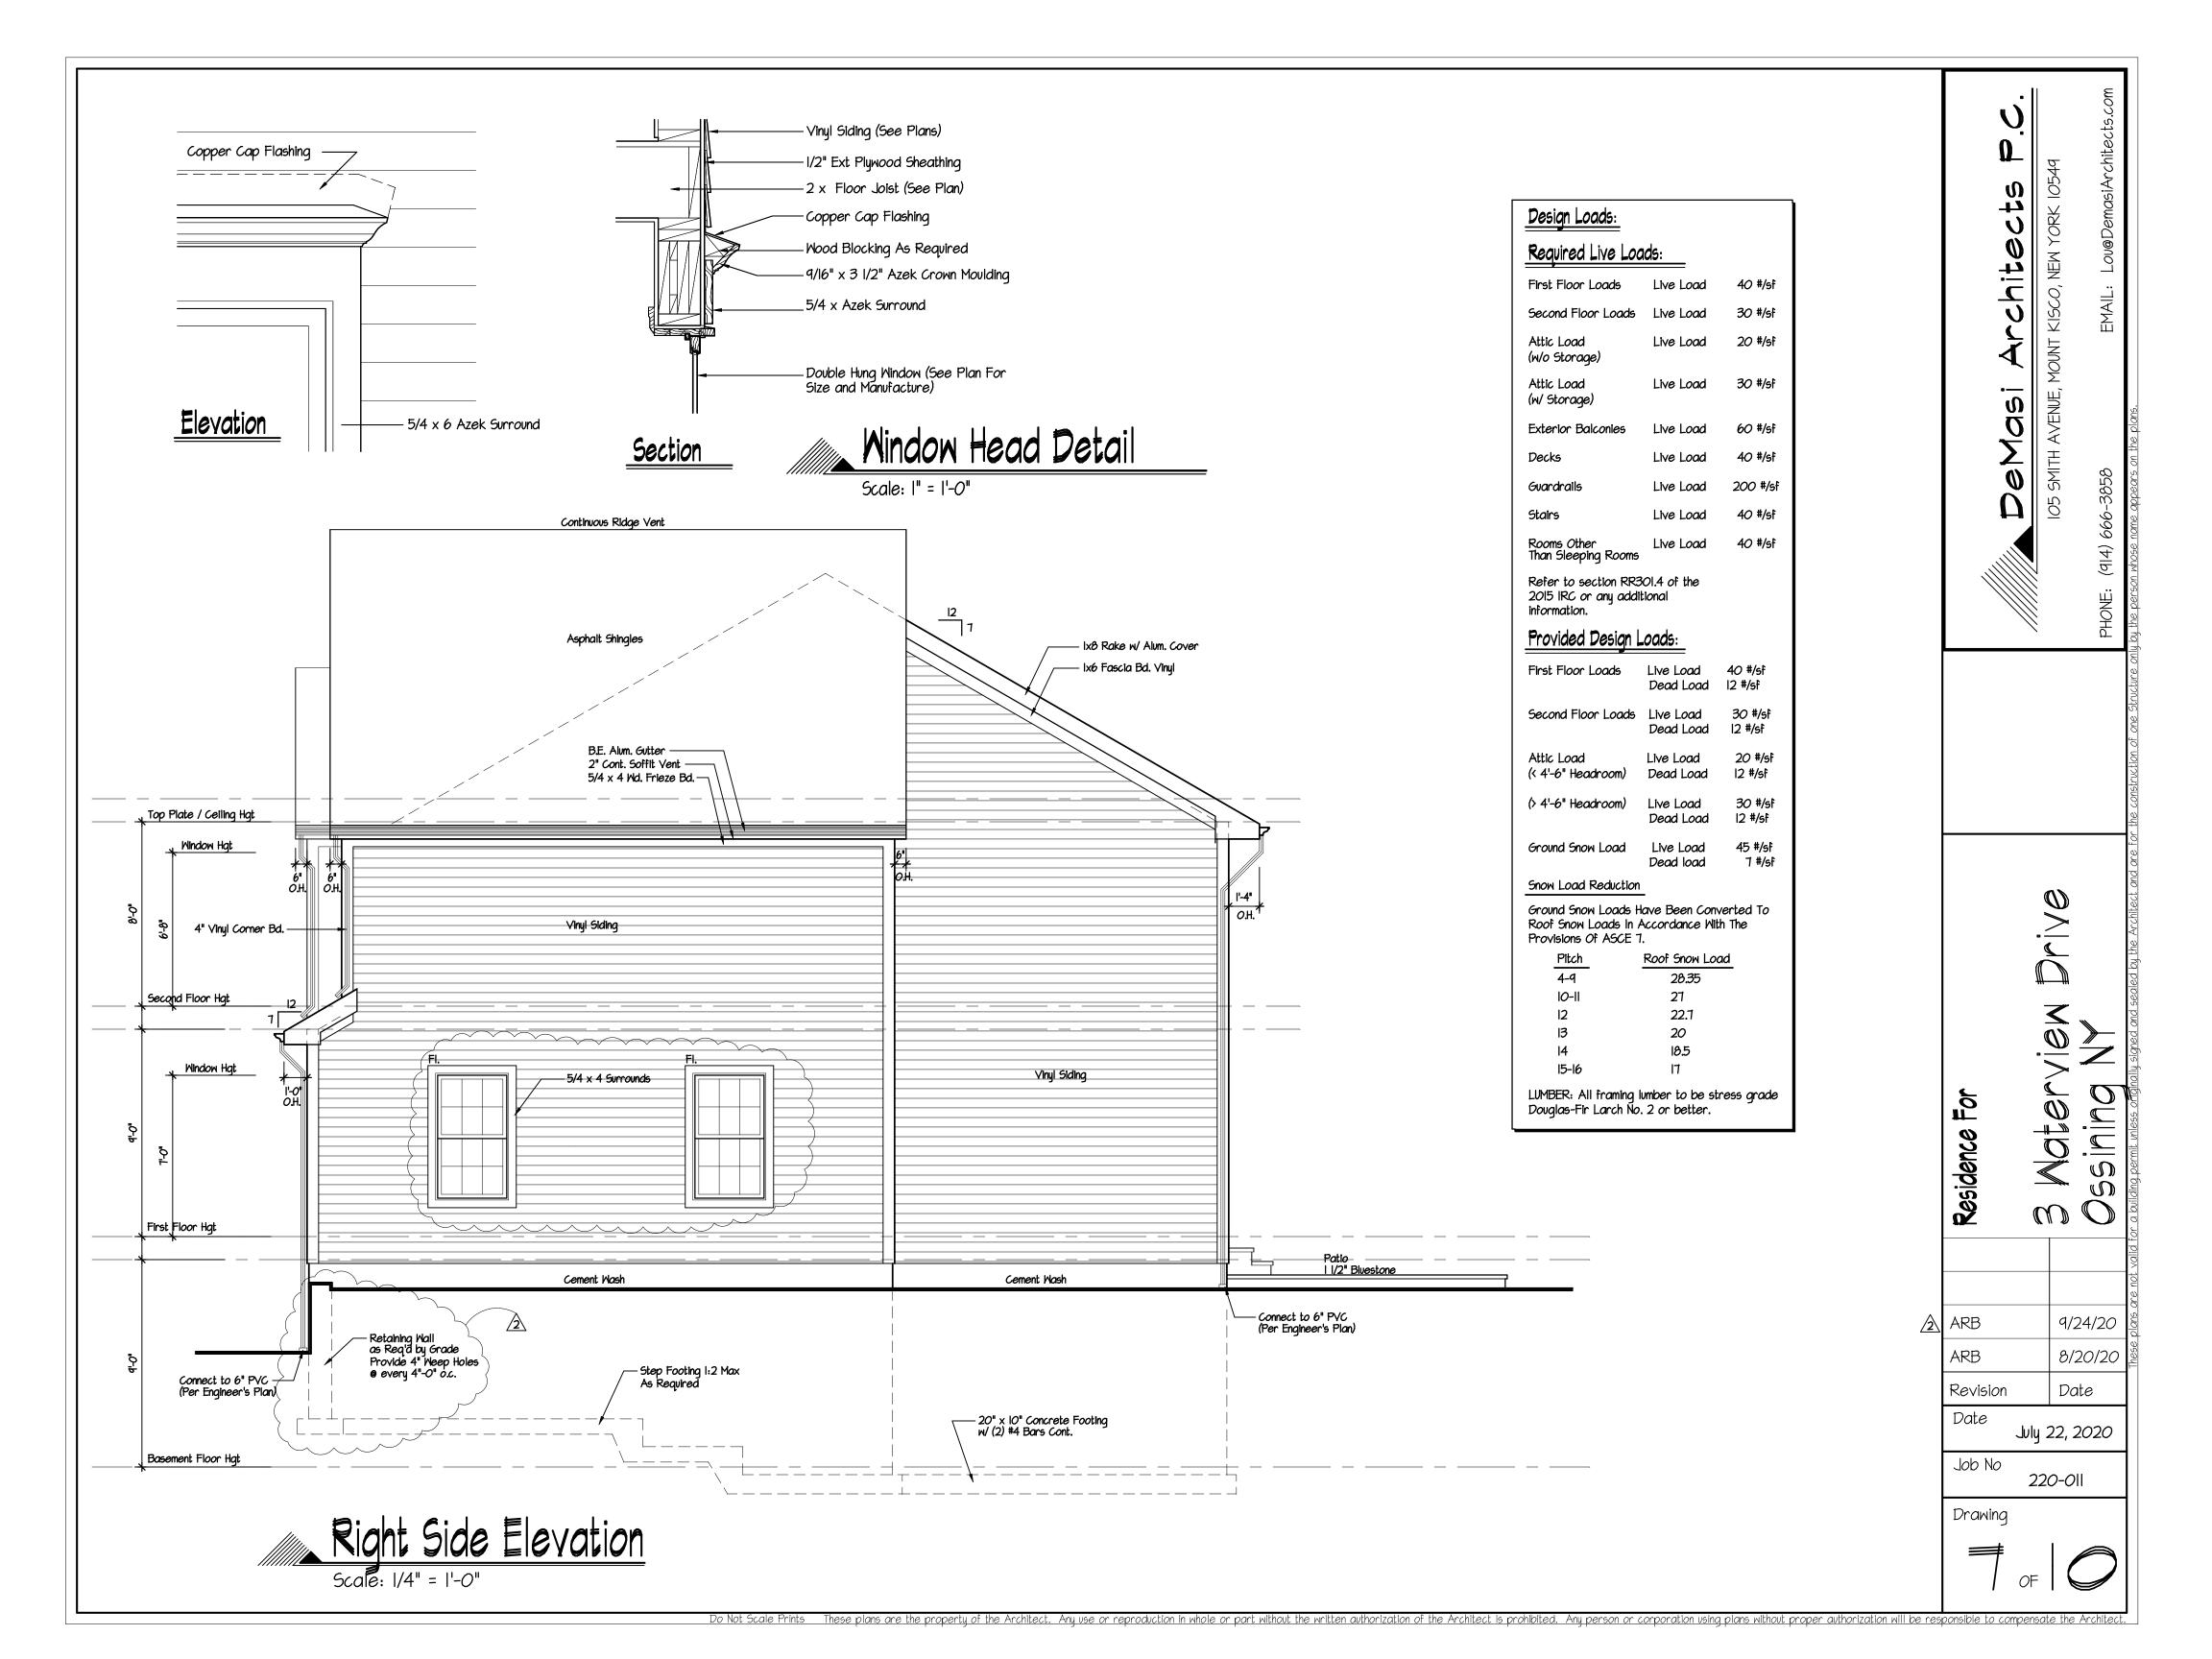

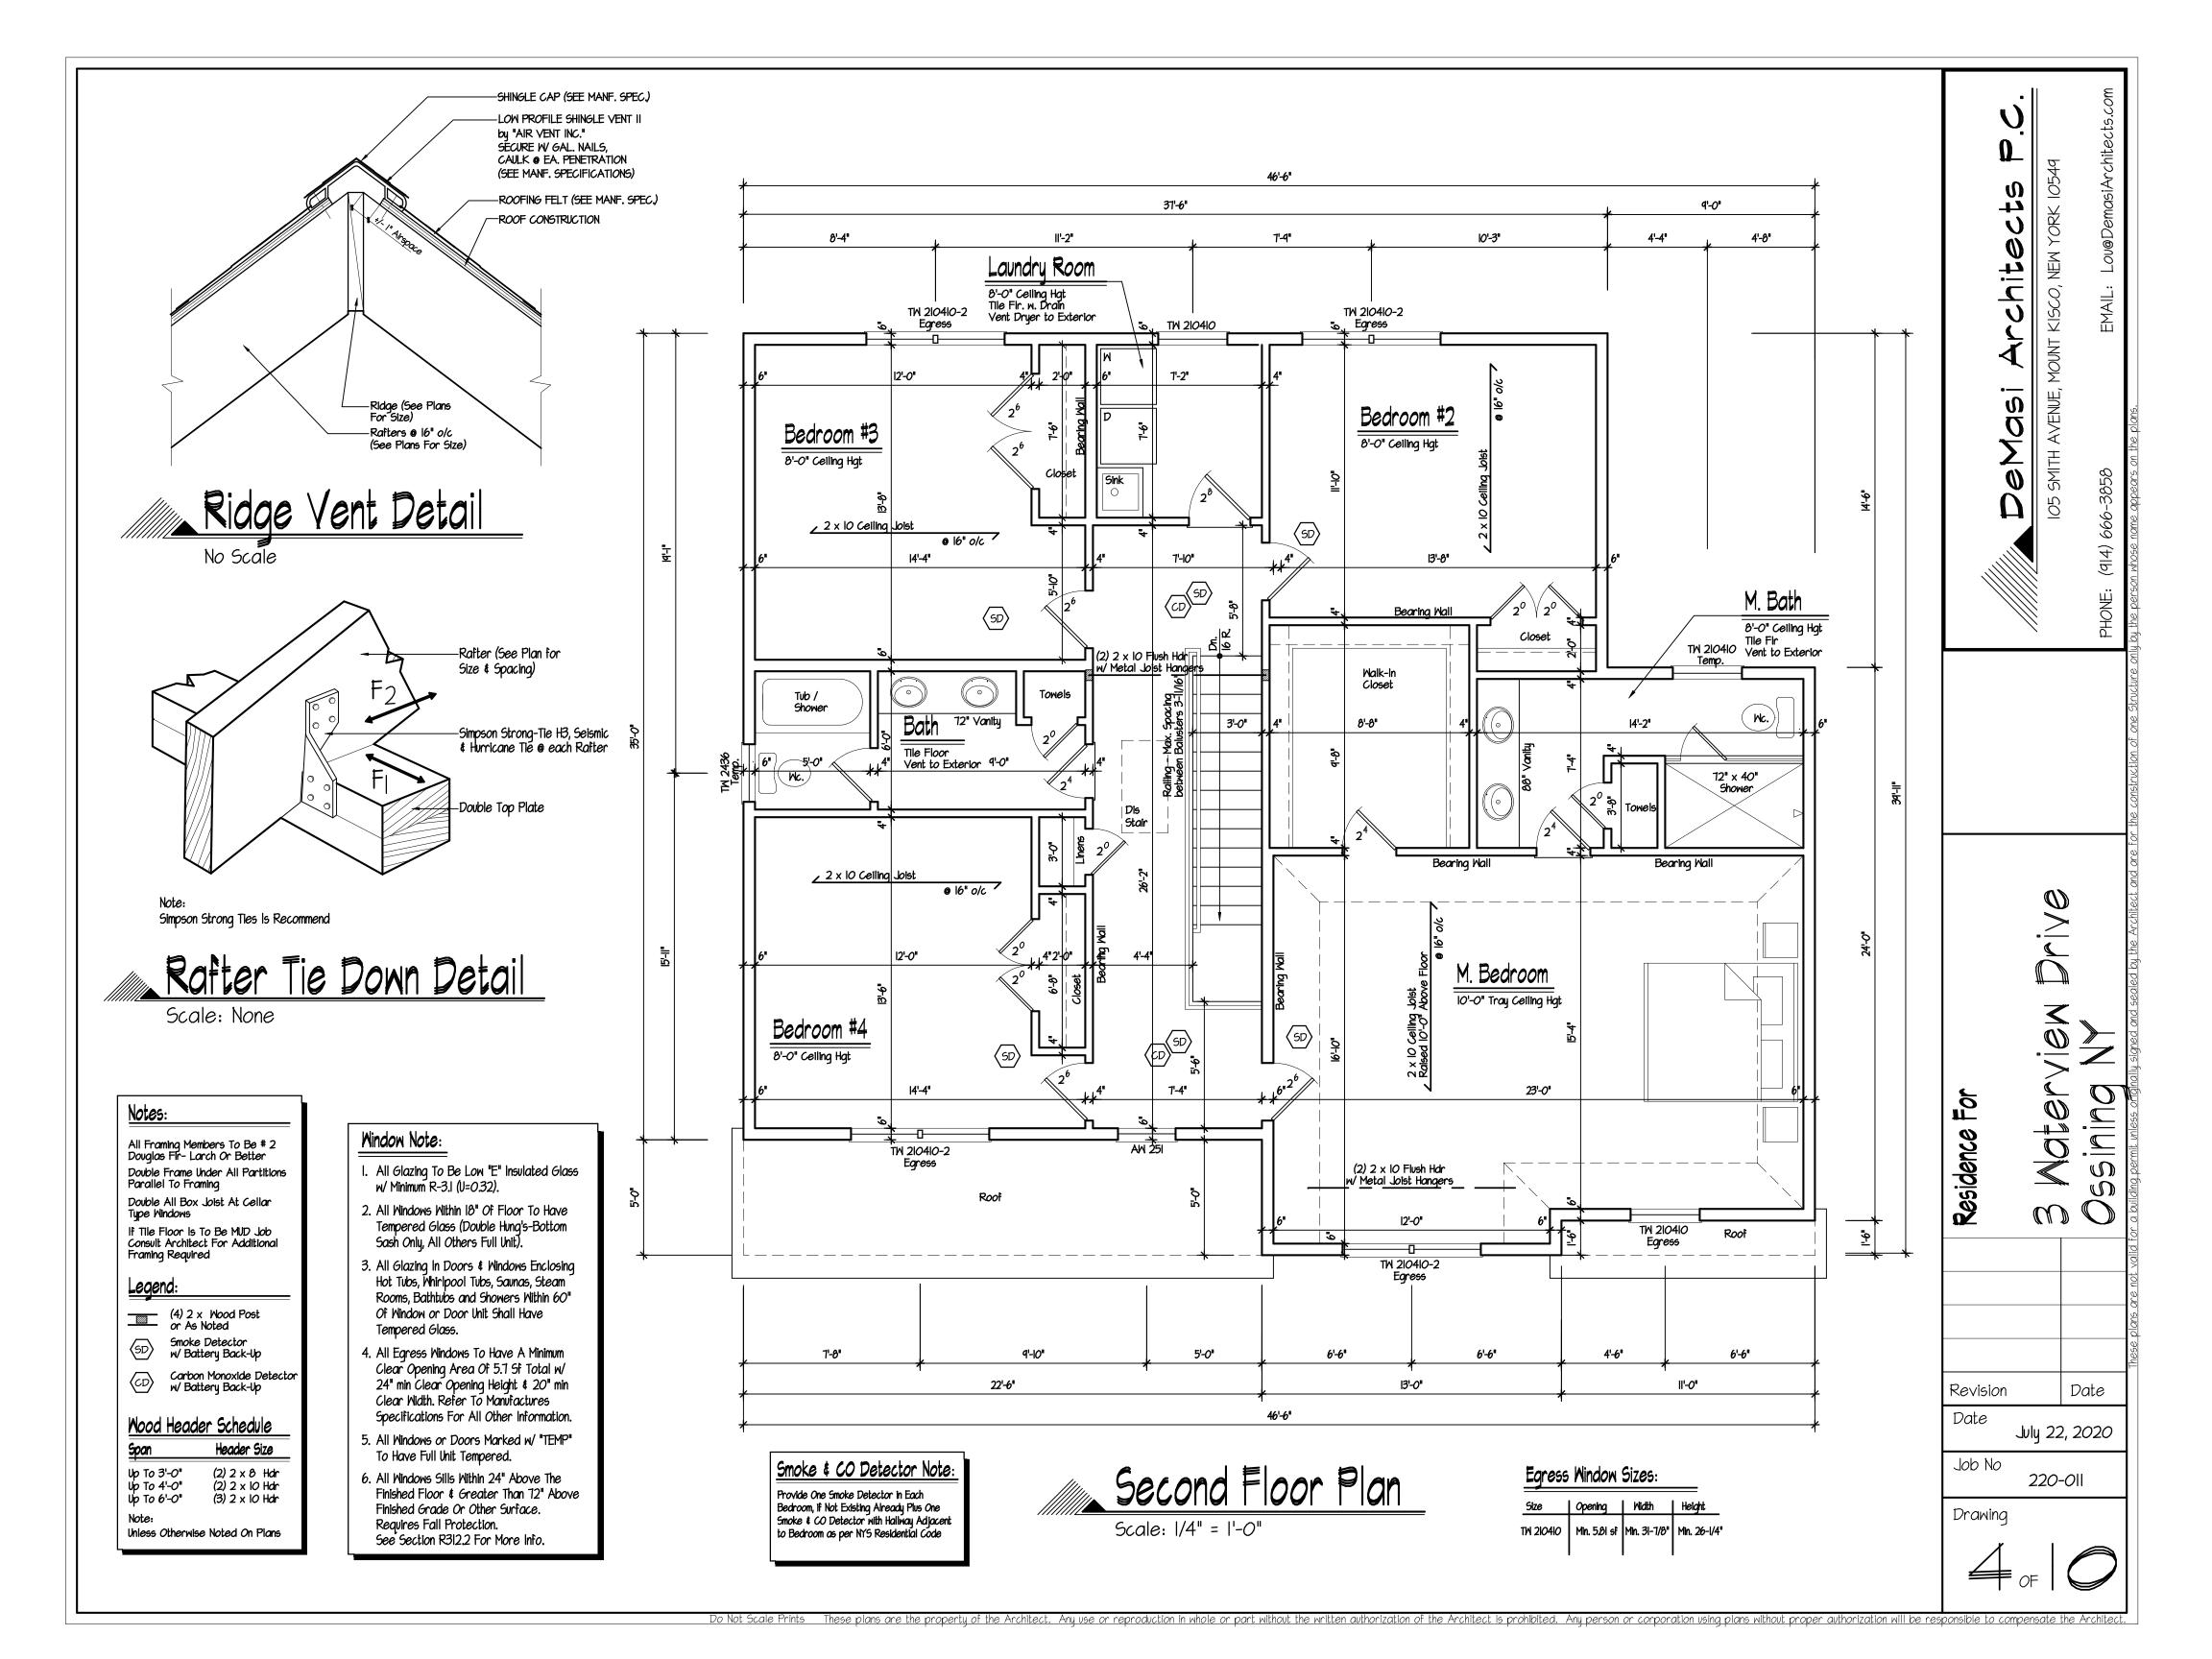


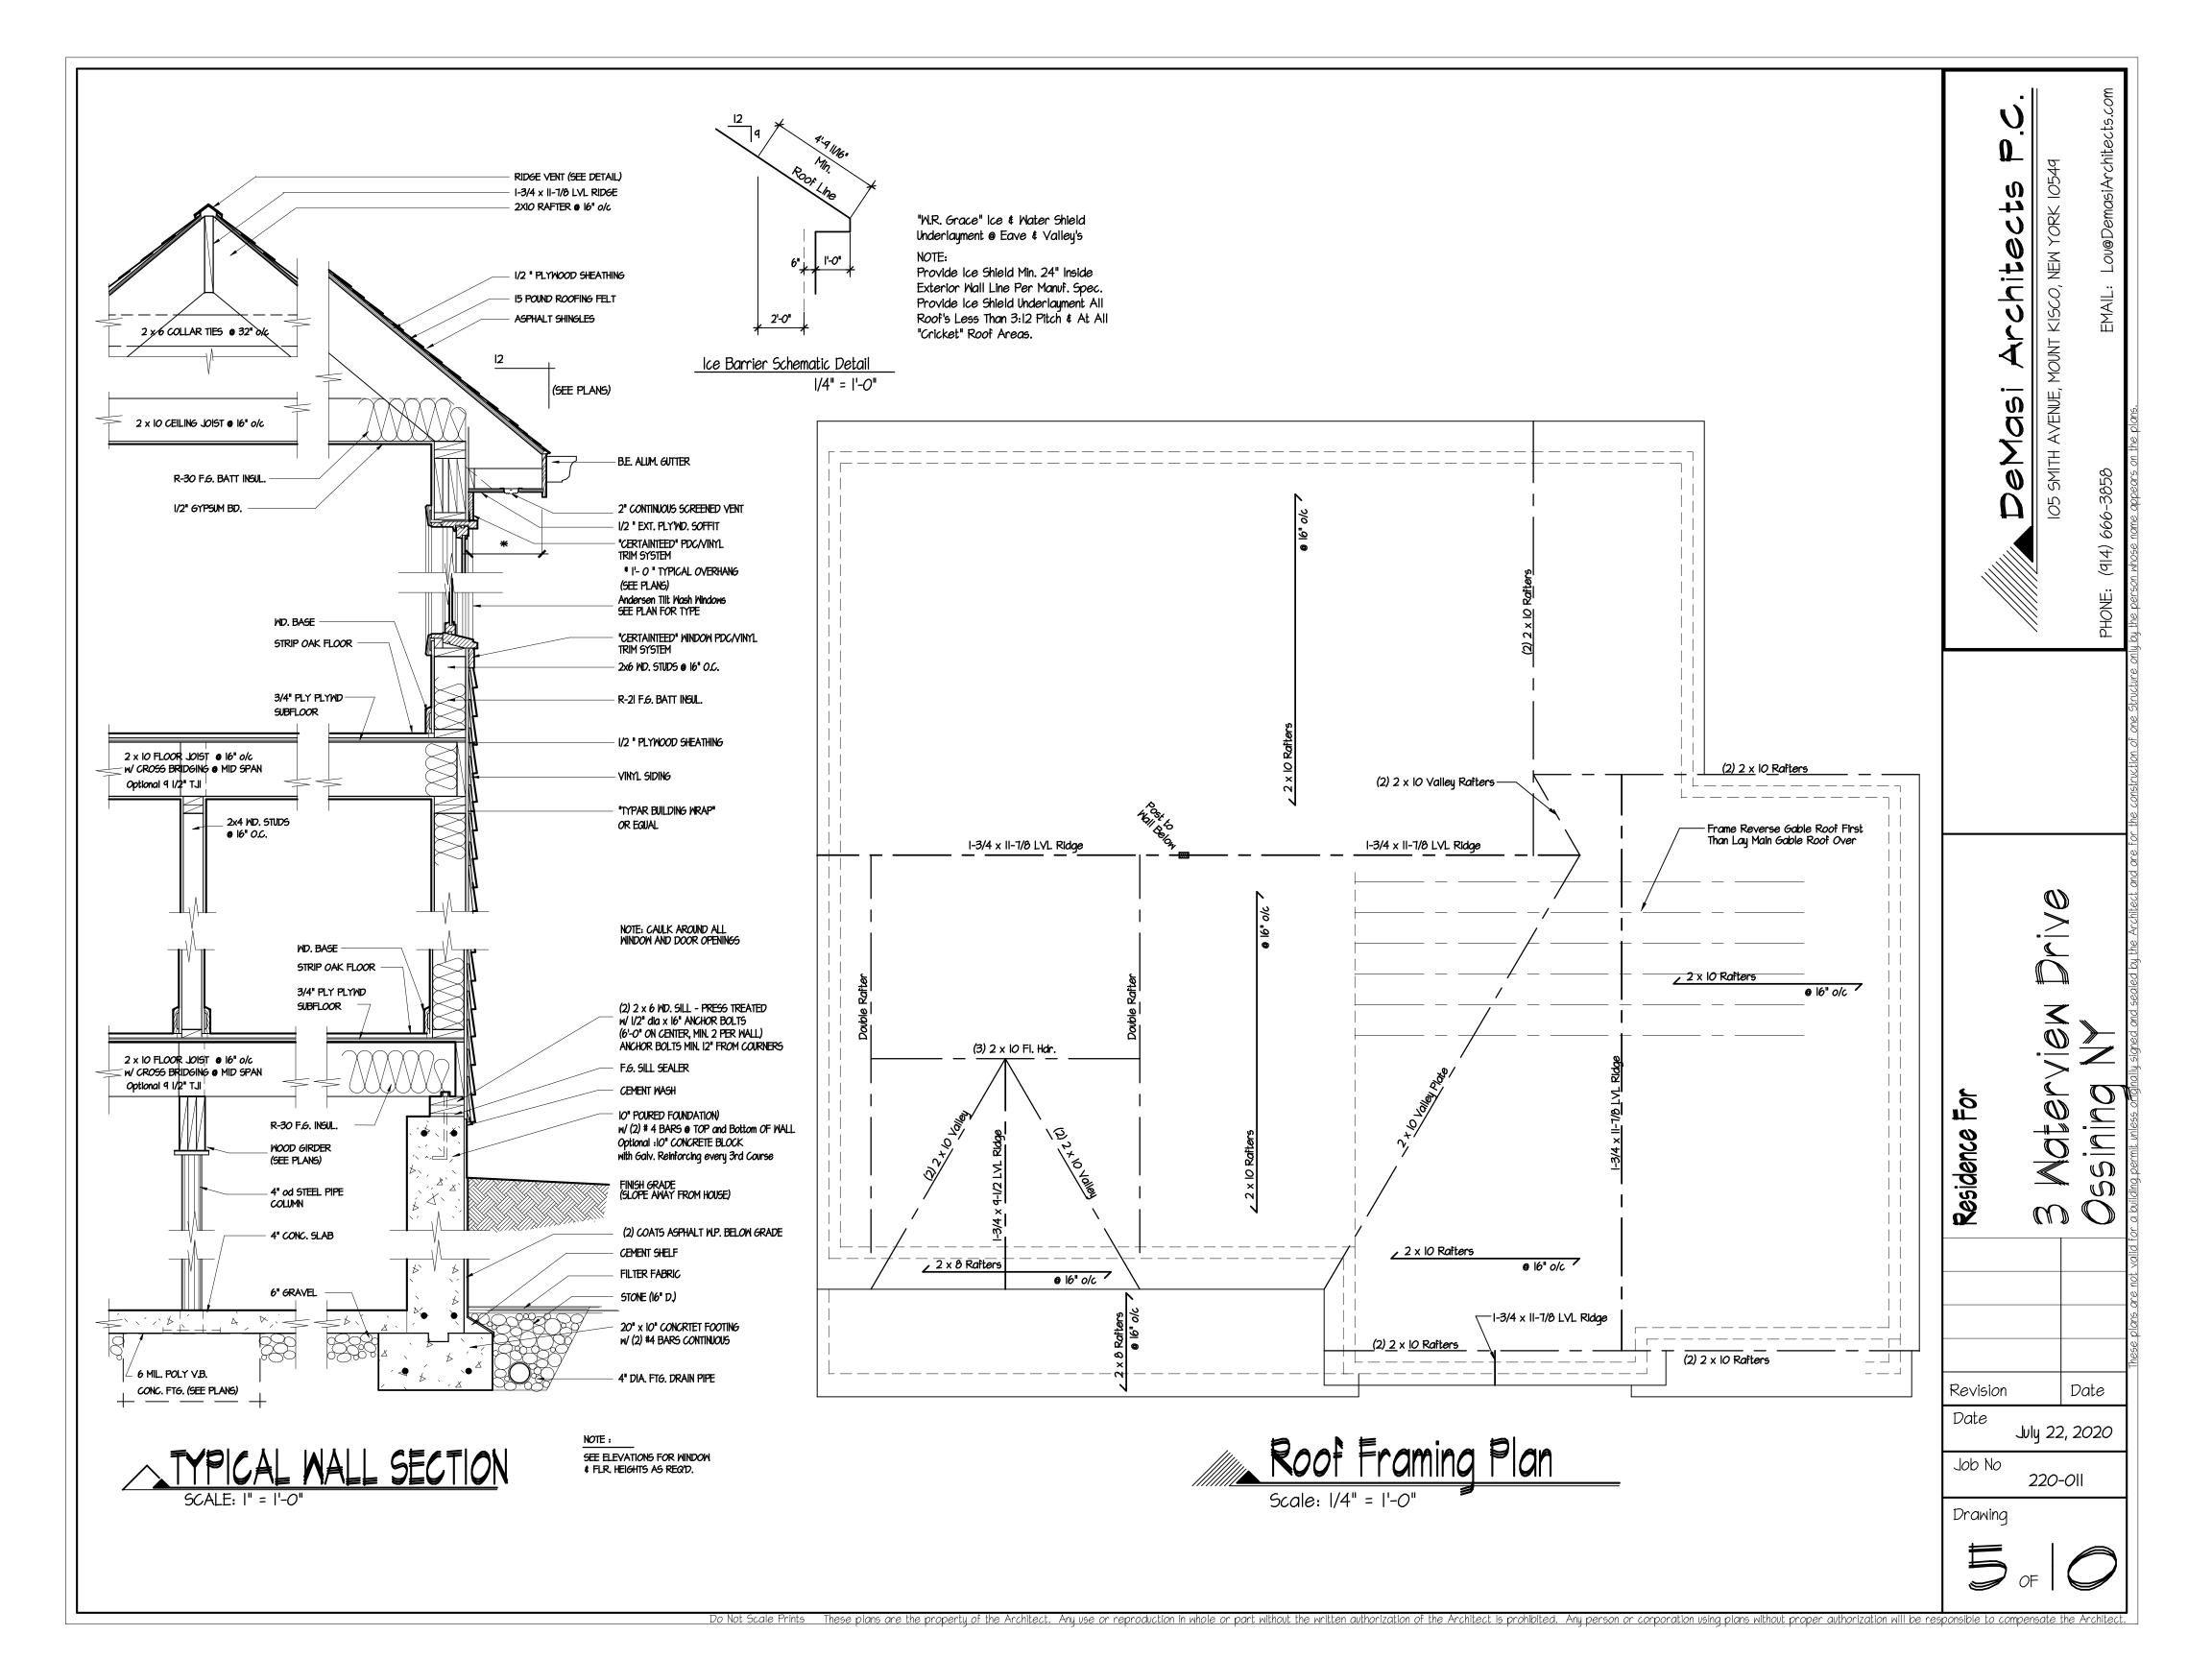

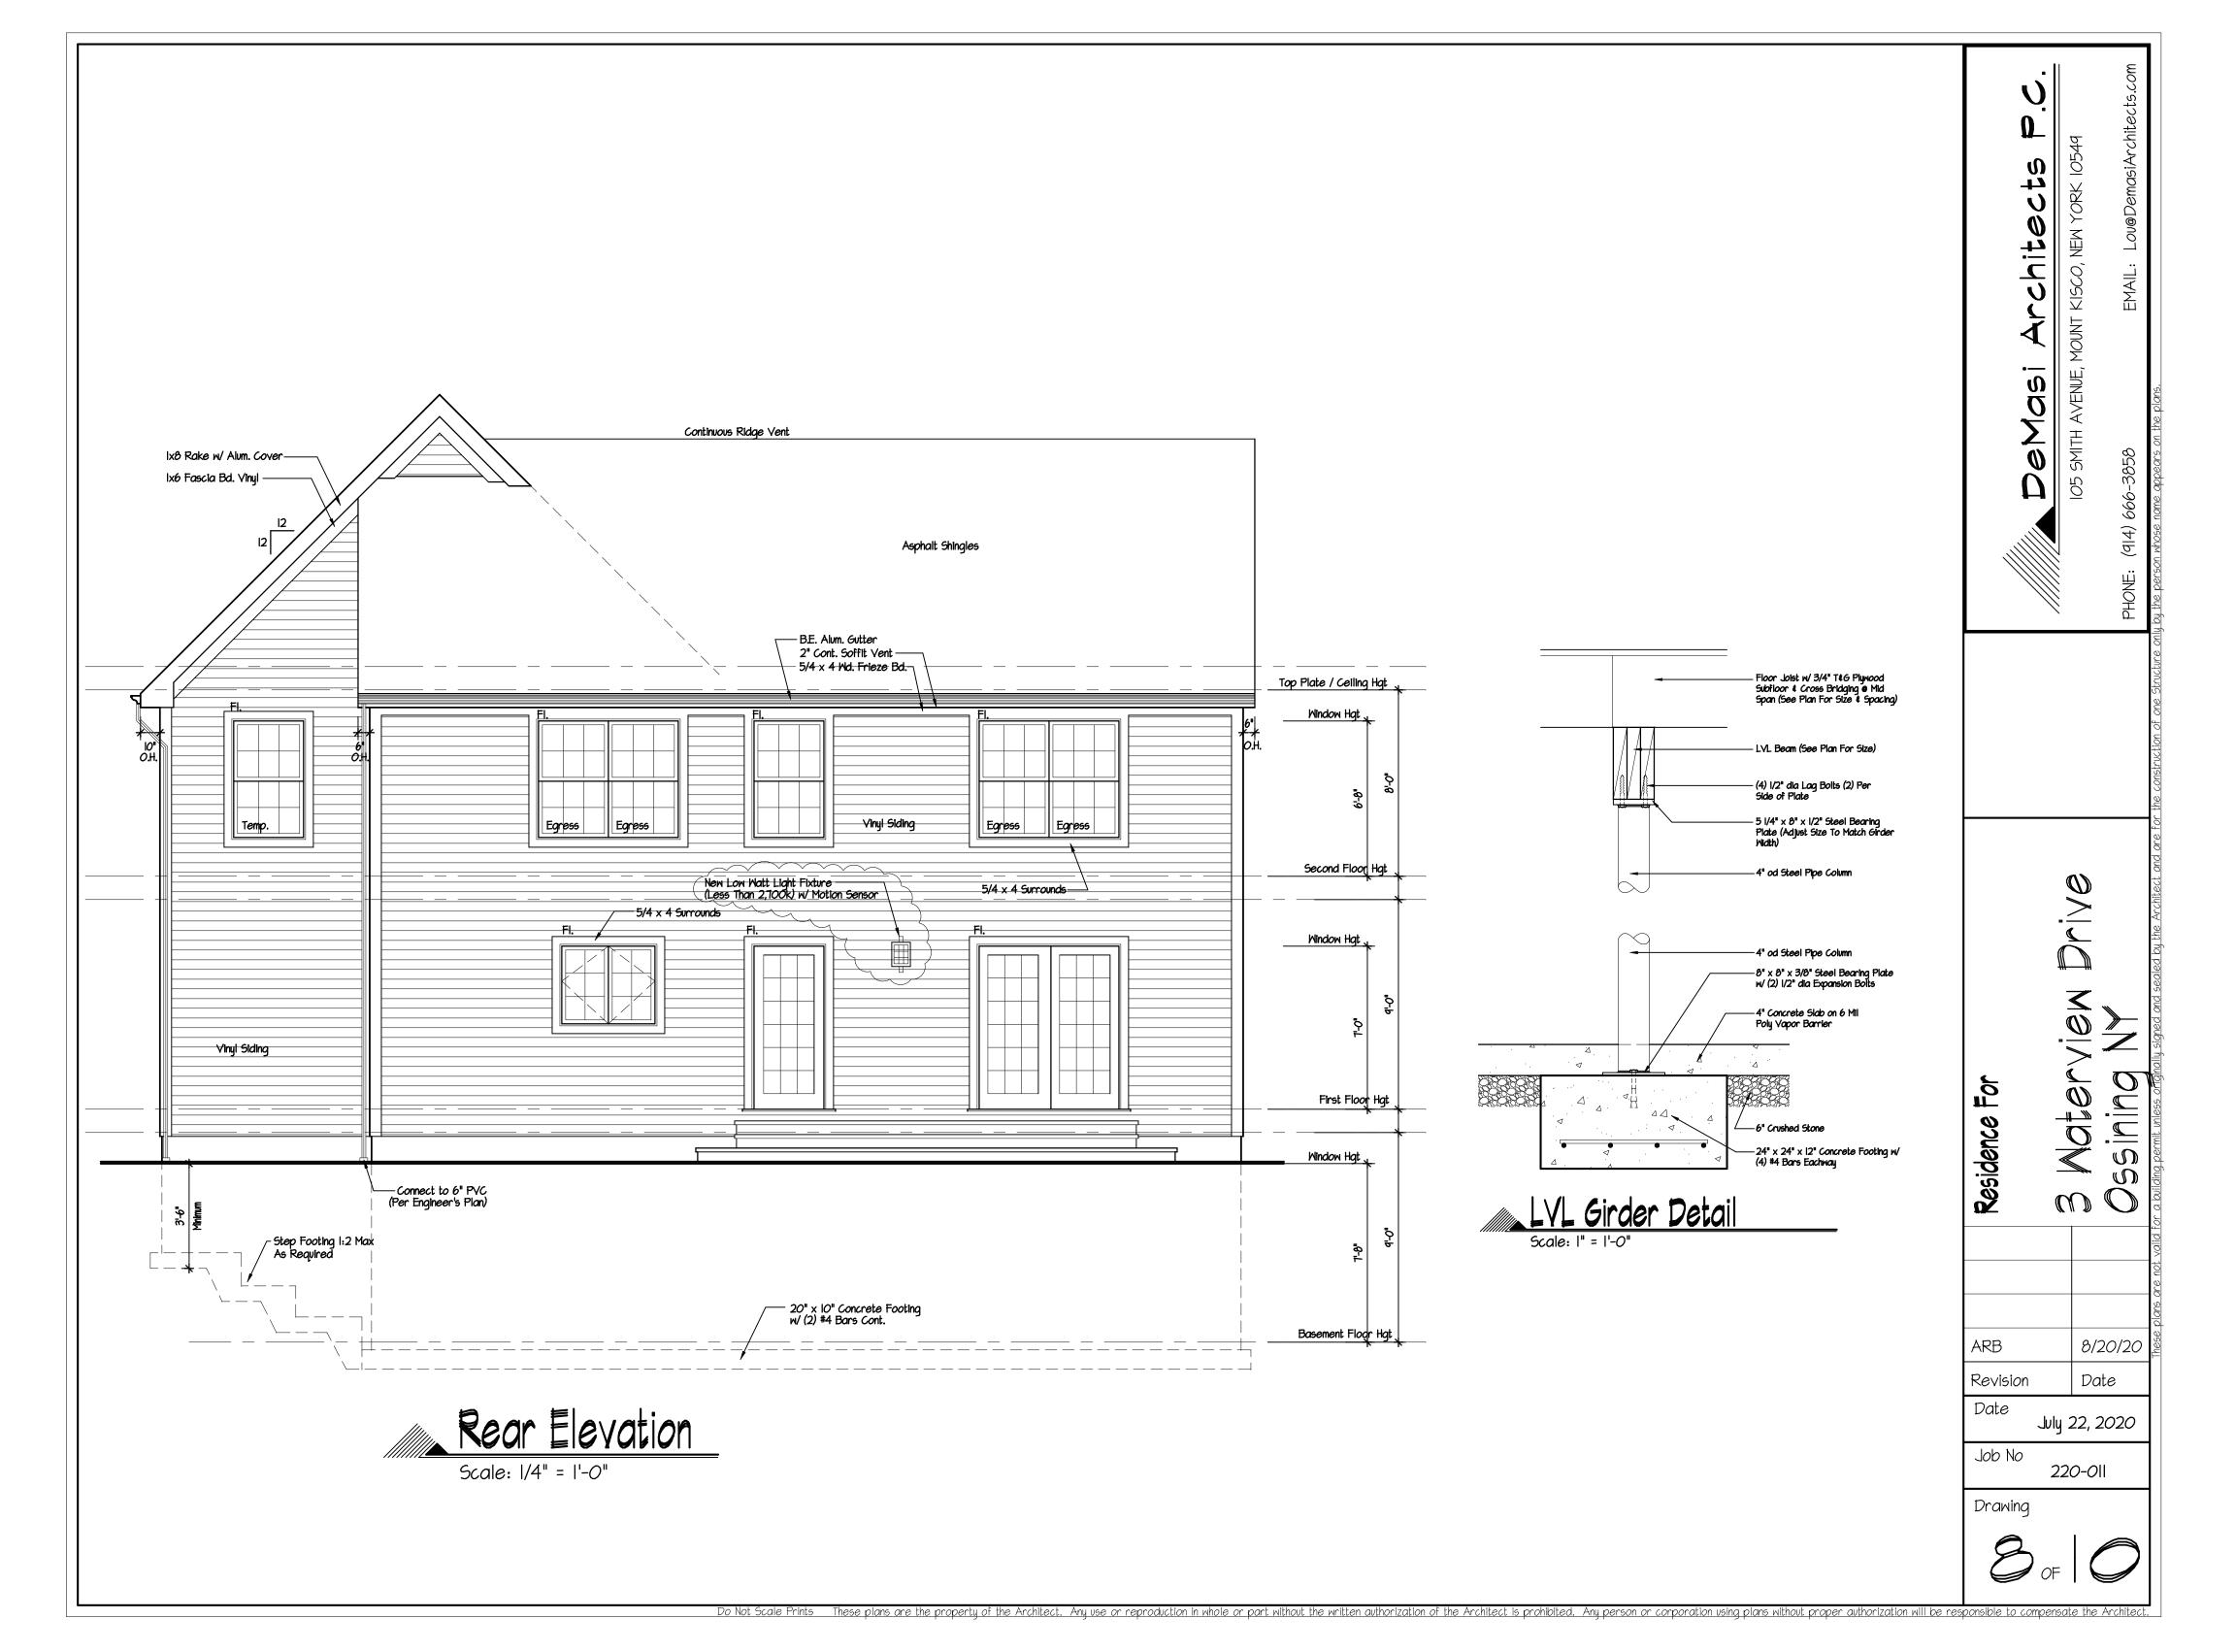

# **ALLOWABLE HOLES - Headers and Beams**


1.55E TimberStrand® LSL Headers and Beams

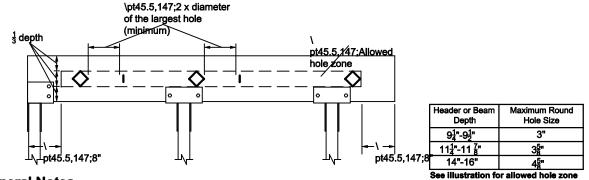

#### **General Notes**

- Allowed hole zone suitable for headers and beams with
- Round holes only
- No holes in headers or beams in plank orientation

#### Other iLevel® Trus Joist® Headers and Beams

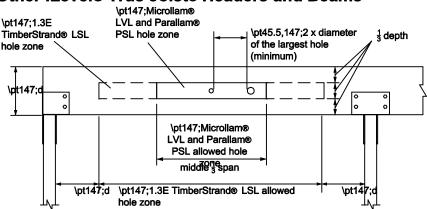



Header or Beam Depth	Maximum Round Hole Size
4 <sup>3</sup> "	1"
5 <sup>1</sup> <sub>2</sub> "	1 <del>3</del> "
7 <del>1</del> "- 20"	2"

#### **General Notes**

- Allowed hole zone suitable for headers and beams with uniform loads only.
- Round holes only
- No holes in cantilevers
- No holes in headers or beams in plank orientation.



NO SCALE

#### General Conditions:

SPECIFICATIONS: These specifications are made in general form only and not specifically for any one building. The owner applying these specifications, assumes complete responsibility for their use, changes, or omissions.

SCOPE OF WORK: The Contractor shall provide all labor, materials, appliances and equipment required to complete all work, etc., as shown on the drawings necessary for a complete job, unless otherwise specified. All material and workmanship shall be of good quality.

OMISSIONS: All written figures (notes and dimensions) on the floor plans or specifications shall take precedence over any drawn figures (elevations). Do not scale prints. All dimensions must be verified by the contractor before start of construction. Any discrepancies on the plans or specificcations must be reported to the Architect prior to the start of construction.

CODES: All work and materials must conform to all local and The 2020 Residential Code Of New York State, National Board of Fire Underwriters, 2020 Energy Conservation Code Of New York State and requirements of the Board of Health.

ACCEPTABLE BUILDING STANDARDS: Installation of materials shall comply with industry standards as instituted by the national association or equivalent group of material used. Acceptable associations shall include, but are not limited to, the following: Western Wood Products Assoc., Cedar Shake & Shinqle Bureau, Brick Industry Assoc., Tile Council of America, National Roofing Contractors Assoc. and American Concrete Institute, etc.

MATERIALS: Shall be installed according to the manufactourer's specifications. All work shall comply with applicable sections of the state and local codes and the generally accepted standards as listed in the state building code.

PERMANENT CERTIFICATION: A permanent certificate shall be completed by the builder or registered design professional and posted on a wall in the space where the furnace is located, a utility room or an approved location inside the building. Where located on an electrical panel, the certificate shall not cover or obstruct the visibility of the circuit directory label, service disconnect label or other required labels. The certificate shall list the predominant R-values of insulation installed in or on ceiling/roof, walls, foundation (slab, basement wall, crawlspace wall and floor) and ducts outside conditioned spaces; U-factors for fenestration and the solar heat gain coefficient (SHGC) of fenestration, and the results from any required duct system and building envelope air leakage testing done on the building. Where there is more than one value for each component, the certificate shall list the value covering the largest area. The certificate shall list the types and efficiencies of heating, cooling and service water heating equipment. Where a gas-fired unvented room heater, electric furnace or baseboard electric heater is installed in the residence, the certificate shall list "gas-fired unvented room heater, "electric furnace"; or "baseboard electric heater," as appropriate. An efficiency shall not be listed for gas-fired unvented room heaters, electric furnaces or electric baseboard heaters. See Section R401.3 Of the 2015 International Energy Conservation Code.

SITE CONDITIONS: The General Contractor shall verify all conditions before submitting his proposal. No allowance for extra charges will be permitted because of lack of knowledge of the conditions peculiar thereto except as otherwise specified elsewhere in the contract documents. Each contractor will be responsible for his own engineering and layout once the owner has established property lines and minimum number of benchmarks. The contractor shall verify all lines, levels and dimensions shown on the drawings and will be held responsible for the correctness and setting out of his work.

OWNERSHIP OF PLANS: These plans are the property of DeMasi Architects P.C. Any use or reproduction, in whole or in part, without the written authorization of DeMasi Architects P.C. is prohibited. Any person or corporation using plans without proper authorization will be responsible to compensate the Architect. This plan is for the construction of one house

ARCHITECT STATUS: Architect has not been retained by owner to provide periodic job inspections or job administration. Purchaser of the plans shall assume full responsibilities for any deviations or changes to these plans.

Do Not Scale Prints These plans are the property of the Architect. Any use or reproduction in whole or part without the written authorization of the Architect is prohibited. Any person or corporation using plans without proper authorization will be responsible to compensate the A

#### Excavation:

FOUNDATION: Excavate all earth, boulders, loose and soft rock to the lines and depths indicated on the drawings. All footings to bear on solid, undisturbed earth. Excavate for all utilities as required.

FOOTINGS: To bear 12" below line of solid undisturbed earth. Design of footings are based on 2,000 psi soil. If soil bearing conditions are questionable, contractor shall consult engineer for footing design. Sloped footings shall be 1:2 max. slope. Provide (2) #4 bars continuous (refer to wall section). All footings bearing from rock to soil shall be reinforced with (4) #5 bars (6' min. on both sides of joint). Dowel and pin all footings bearing on rock with a slope greater than 7:12 (30 degrees) w/ #4 dowels @ 24" o/c

FINISH GRADING: Finish grading shall be established to provide surface drainage in all directions away from the house and excavated areas.

### Concrete & Masonry:

Weathering Condition: Severe

CONCRETE: Shall be a min. F'c = 3,000 psi compressive strength for footings & foundation walls and F'c = 3,500 psi compressive strength for porches, steps \$ garage floors. Concrete shall be "Air Entrained", total air content shall not be less than 5 % or more than 7 %. All concrete work shall conform to the lastest American Concrete Institute (ACI) quidelines.

CONCRETE FLOORS: Shall have a smooth, dense steel trowel finish, suitable to receive composition flooring. Concrete floors in living areas shall have 6 mil. poly vapor barrier and 2" x 24" (min.) rigid polystyrene foam insulation around the perimeter of the slab, where slab is within 2'-0" of grade. Pitch all garage and porch floors for drainage. (1/8"/ft. min.)

POURED CONCRETE FOUNDATION: Shall comply with the latest edition of American Concrete Institute Specification and shall be plumb, straight, level and true. Forms to be properly constructed to hold concrete. Provide (2) #4 bars located at top and bottom of wall. All reinforcing bars for concrete work shall conform to A.S.T.M. A615 grade 60.

MASONRY: Concrete block shall be load bearing laid level, plumb and straight in a full bed of cement mortar (TYPE "S") with galvanized metal truss-type ties @ 24" horizontal and vertical. All joints to be well tooled. All masonry work shall conform to ACI 530 code and all reinforcement work shall conform to ACI 318-71. Fill top two courses solid with cement mortar.

MASONRY CHIMNEY & FIREPLACES: Where shown on the plans, shall be brick or stone where exposed and laid in a full bed of cement mortar with well too'led joints. Flues to be fire clay, size shown on the plans. Provide cast iron damper, ash pit and clean-out doors. Provide for proper clearances with combustible construction. Firestop at all clearances with non-combustible material. Contractor shall ensure proper clearances of chimney and fireplace per 2020 Residential and Energy Codes Of New York State.

PRE FAB CHIMNEY AND FIREPLACE: Installation of prefab flues and fireplaces shall be in strict accordance with manufacturer's specification. Install firestops as required by code. Fireplace shall be metal prefab with compatible flue and shall be UL listed.

FIREPLACES: All fireplaces shall have tempered glass fire doors and closable combustion air intake ducts and comply with the 2020 Energy Conservation Code Of New York State.

DAMPROOFING: Foundation wall shall be damproofed with two (2) coats of asphalt waterproofing over 1/2" cement parge (block wall) or cement wash (poured wall). Provide 4" perforated pipe footing drain laid in 16" stone with layer of filter fabric. Drain to outflow above ground or stone drywell.

DAMPROOFING: Provide a complete TUFF-N-DRI Exterior Foundation Waterproofing System as manufactured by KOCH MATERIALS COMPANY or equal. Provide 4" perforated PVC footing drain laid in 16" deep (min.) stone with a layer of filter fabric over. Drain to outflow above ground, min. 30' from house, when not permitted, provide drywell.

DAMPROOFING: In areas of high water table or severe soil-water conditions are known to exist, provide 2-ply hot mopped felts, 55 pound roll roofing from top of footing to finished grade. All joints are to be lapped and sealed with adhesive.

4 70RX O 0 <u>.</u> K1900, V MOUNT S  $\sum_{Q}$ SMITH 0 (4|4) Residen Revision Date Date July 22, 2020 Job No 22*0-0*II Drawing

#### Miscellaneous Metals:

STEEL: Shall conform to ASTM specification A-36 for structural steel.

FLITCH BEAMS: All steel plates shall conform to ASTM specifications A-36 for structural steel. All bolt holes to be properly drilled. Torched holes are not acceptable.

ANCHOR BOLTS: Providel/2" dia. X 16" with hooked end. Bolts to be placed 6-0" o.c. max., 12" min. from corner and 2 bolts min. per sill. Consult Architect for anchoring in other seismic zone.

#### Carpentry:

Decay Design Condition: Slight - Moderate

Termite Design Condition: Moderate - Heavy.

Design Loads;

First Floor Loads	Live Load Dead Load	40 #/sf 12 #/sf
Second Floor Loads	Live Load Dead Load	30 #/sł 12 #/sf
Attic Load (< 4'-6" Headroom)	Live Load Dead Load	20 #/s 12 #/sf
(> 4'-6" Headroom)	Live Load Dead Load	30 #/s 12 #/sf
Ground Snow Load	Live Load Dead load	45 #/s 7 #/s

Wind Speed Design load: 115-120 mph

LUMBER: All framing lumber to be stress grade Douglas Fir Larch No. 2 or better.

FRAMING: Framing of the entire house shall be erected plumb, level and true, securely nailed. Joists, studs and rafters shall be doubled above all openings. All flush headers shall be connected with metal joist hangers. Double frame under all partitions parallel to framing. Sizes of joists, sheathing and rafters are shown on plans. Provide solid blocking under all posts. Contractor to provide all fire blocking at all stud wall over 10'-0" high or all horizontal furred spaces at 10'-0" intervals max.

TERMITE SHIELD: Shall be bent aluminum with sealed lapped joints (refer to wall section for other information).

SILL PLATES: All wood sill plates that rest on concrete or masonry exterior walls shall be pressure preservatively treated in accordance with AMPA standards or shall be of decay-resistant heartwood of redwood, black locust, or cedars. All sill plates to be set on fiberglass sill sealer or equal.

GLULAM BEAM: Shall be No. I Douglas Dir (min. Fb-2200 PSI).

LAMINATED VENEER BEAM: Shall be "Microlam I.9E" by Trus Joist Weyerhaeuser or equal, min. fb. 2600. Install as per manufacturer's specifications. Install as per manufacturer's specifications.

PLYWOOD JOISTS: Shall be "TJI" Joists by Trus Joist Weyerhaeuser. Install as per manufacturer's specifications.

SUB FLOOR: Shall be 23/32" AdvanTech Flooring w/manufacture recommendation for glue and screwed to each framing member @ 6" o/c.

SHEATHING: Shall be 1/2" exterior grade plywood nailed to each framing member.

WOOD DECKS AND RAILINGS: Where shown on plans, shall be pressure treated No. I Southern yellow pine wood. All nails, bolts and all metal fastenings to be hot-dipped galvanized steel, silicon bronze or copper (see

BRICK OR STONE VENEER: Shall be as shown on plans, laid in cement mortar with galvanized metal wall ties 24" horizontal and vertical. Provide weep holes at 4' o/c max. or as required (option: provide "MortarNet" at bottom of cavity). All joints to be well tooled. Brick and/or stone shall be selected by owner.

WINDOWS: Shall be ANDERSEN "400 Series" or equal windows with insulated "Low E" glass and screens. Size and type shown on plans. Provide tempered glass where shown or where within 18" of floor.

FRENCH DOORS: Shall be ANDERSEN Frenchwood or equal with tempered insulated "Low E" glass and screens.

VINYL SIDING: Shall be vinyl as manufactured by "WOLVERINE TECHNOLOGIES" Millennium series, complete w/ millennium series coordinates. Color to be selected by owner.

INTERIOR DOORS: Interior doors shall be I 3/8" flush mahogany stain grade or 6 panel pre-hung units, complete with hardware and casing. Siding, bi-fold and pocket doors shall be I 3/8" flush mahogany or 6 panel doors or as shown on plans, complete with hardware. Provide a self-closing "30 Min." label insulated door and frame between garage and house.

EXTERIOR TRIM: Shall be "Azek" or Equal. Size and shape shown on plans.

INTERIOR TRIM: Shall be stock sections of pine and shall be neatly fitted and mitered and complete, including doors and window casings, aprons, and stools, base at the floor. Closets to have one 3/4" shelf with clothes pole adequately supported. Linen closets to have five (5) 3/4" shelves.

WOOD STAIR: Provide oak tread stair, size shown on the plan. Provide complete hardwood railing, post, newel, and balusters (4 1/2" o..c. max.). as required. Stair to have oaktread (10" w/ 1 1/8" nosing @ closed stair), clear pine stringer and risers (8 1/4" max.). Provide oak tread return and bullnose on open sides. Stair shall be glued and wedged. All trim to be mitered and glued. Stair shall be fabricated in millshop by professional stair-builder. The general contractor shall be responsible to field check and verify stair dimensions and compliance with local & state building codes.

FLOORS: Wood floors shall be 25/32 strip oak securely nailed to joists over a layer of rosin paper. Composition floors shall be 1/16" vinyl set in mastic on concrete, or 5/8" exterior A/C plywood underlayment in joist areas.

ATTIC/ CRAWLSPACE ACCESS: Access doors from conditioned spaces to unconditioned spaces such as attics and crawl spaces shall be weatherstripped and insulated to a level equivalent to the insulation on the surrounding surfaces. Access shall be provided to all equipment that prevents damaging or compressing the insulation. A wood-framed or equivalent baffle or retainer is required to be provided when loose-fill insulation is installed, the purpose of which is to prevent the loose-fill insulation from spilling into the living space when the attic access is opened, and to provide a permanent means of maintaining the installed R-value of the loose-fill insulation. See Section R402.2.4 Of the 2020 Energy Conservation Code Of New York State.

BUILDING CAVITIES: Building framing cavities shall not be used as ducts or plenums As Per Section R403.3.5 Of the 2020 Energy Conservation Code Of New York State.

ROOFING: All chimneys shall be properly flashed. Provide self-sealing rubberized waterproof membrane (36" wide min.) at all eaves, openings, hips, valleys, and ridges by W.R. Grace and Company or equal (ice and watershield). All roofing shall be installed by qualified roofing contractors, in strict accordance with manufactourer's specifications.

ASPHALT SHINGLE ROOF: Shall be 30-yr rustic asphalt shingles laid on 15 lb. roofing felt.

ROOF VENTILATION: Ventilate all attic and rafter spaces with proper sized screened ridge and soffit vents or louvers (see plans).

GYPSUM BOARD: 1/2" nailed with rosin nails according to manufacturer's specifications. All joints to be taped and receive three (3) coats of joint compound. Finish to be smooth and even, ready for painting. Provide 5/8" type "X" gypsum board at both sides of garage house walls and cellings. Also, provide 100 SF min. over furnace.

GUTTERS AND LEADERS: Provide baked enamel gutters and leaders as required. All leaders and gutters are to be properly supported at all joint areas.

INSULATION: Shall be fiberglass batts with vapor barrier. Provide insulation as per 2020 International Energy Conservation Code Of New York State Section R402. RES-CHECK software is allowed to be used to calculate insulation requirements.

#### Tile Work:

CERAMIC TILE: Baths and lavatory floors to receive matt glazed ceramic tile set in thin-set grout. Installation to be as per latest edition of the Tile Council of America specifications. Consult Architect if other setting methods are to be used to verify floor structure. Tub and shower wall to receive glazed ceramic tile set in mastic 6' high (min.) Provide water-resistant cement backer boards to tub shower walls and wet areas.

ACCESSORIES AND ATTACHMENTS: Provide ceramic accessories such as soap dish, paper holder, 2 towel bars per bath. Provide mirror medicine cabinet with light over. Provide formica stock vanity where shown on plans.

# Painting:

EXTERIOR: Siding, fascias, and trim shall receive one (I) prime coat and one (I) finish coat of exterior stain or paint.

INTERIOR: Walls to receive one (I) prime coat and one (I) finish coat of latex or oil flat paint. Flush hardwood doors to receive one (I) coat of stain and one (I) coat of satin polyurethane finish. Six (6) panel doors to receive one (I) coat primer and one (I) coat of satin enamel finish. Floors to be sanded and receive one (I) coat of sealer and one (I) coat of floor polyurethane, gloss finish.

TRIM AND MISCELLANEOUS WOOD: Shall have one (1) prime coat and one (1) finish coat of satin enamel.

# Heating:

HEATING and AIR CONDITIONING: Shall be oil-fired hydroair system, complete with boiler, hydronic zone controls, thermostates, oil tank, etc for 5 zones. Provide domestic hot water coil or separate circulating storage tank if required in boiler. Provide air handling units, condensers, insulated supply ducts and vents to each room. Heating and cooling system to be designed and guaranteed to conform to the latest ASHREA specifications and the 2020 Energy Code Of New York State. Heating system shall be designed and guaranteed to maintain 73° degrees F indoor temperature with 7° degrees F outdoor temperature.

DUCTS: All ducts shall be fabricated and rigidly installed with required bracing and supports. The main supply and return duct shall be isolated from the heater and blower by means of fabric insulators. Provide duct damper for each run. Insulate all ducts located in garage, attic, and unheated areas

DUCT TESTING: Ducts shall be pressure tested to determine air leakage by one of the following methods: Rough-in test Or Postconstruction test. A written report of the results of the test shall be signed by the party conducting the test and provided to the code official. See Section R403.3.3 Of the 2020 Energy Conservation Code Of New York State.

EQUIPMENT SIZING AND EFFICIENCY RATING: Heating and cooling equipment shall be sized in accordance with ACCA Manual 5 based on building loads calculated in accordance with ACCA Manual J or other approved heating and cooling calculation methodologies. New or replacement heating and cooling equipment shall have an efficiency rating equal to or greater than the minimum required by federal law for the geographic location where the equipment is installed. See Section R403.7 Of the 2020 Energy Conservation Code Of New York State For More Detail.

GRILLS AND REGISTERS: Provide supply and return registers in each room. All supply grills to have adjustable dampers.

BALANCING: Heating contractor shall balance entire house so that all rooms heat evenly to the required temperature set on the thermostat.

#### Plumbing:

MORK INCLUDED: Contractor shall furnish all labor, materials and equipment required to fully complete all plumbing work shown on plans.

FLASHING: All pipes passing through roof shall receive aluminum collar, strapped and fitted to provide water-proof seal.

TESTING: Contractor shall test all water, drainage, and vent piping in accordance with local codes.

WATER SUPPLY: Water supply in street or well shall be extended to house with I" heavy copper pipe and entire house shall be supplied with both hot and cold water by means of heavy copper pipe of appropriate sizes, min. 3/4" sub main to each bath, kitchen, and laundry. The weather resistant hose fittings shall be supplied. Provide hook-up for washer where shown.

DRAINAGE SYSTEM: Shall be installed in accordance with local codes and ordinances and shall be complete with copper drains and copper vents, cleanouts, etc connected to street sewer or septic system. Drains under concrete to be cast iron.

FIXTURES: As shown on plans shall be AMERICAN STANDARD, KOHLER, or equal. All exposed fittings and pipe to be chrome plated.

SEPTIC AND WELL SYSTEMS: (if required) shall conform to all requirements of the Board of Health.

#### Electrical:

Electrical system to be designed to comply with NEC 70 specification.

Electrical: Provide a minimum of 120/208-200 amp, or larger, if required, for service. Switches to be silent type. Locations of outlets, fixtures, etc, as shown on plans. All electric work to conform to the National Board of Fire Underwriters Codes. Provide a complete door bell system.

Contractor to provide exhaust fans at bath rooms (vent to exterior). Provide & install as per code.

Contractor to provide smoke & heat detectors with battery back-up (see plans for location). Detectors shall conform to all applicable codes and shall be installed as per code R314.3. Hard-wire and interconnected per section R314.4

Contractor to provide carbon monoxide detectors with battery back-up (see plans for location). Detectors shall conform to all applicable codes and shall be installed as per building code. Section R315.1

Lighting Equipment: Not Less Than 75 Percent Of The Lamps Provided In Permanently Installed Light Fixtures Are High Efficacy Lamps Or Not Less Than 75 Percent Of The Lamps In Permanently Installed Light Fixtures Shall Contain Only High Efficacy Lamps As Per R4O4.1 Of The 2020 Energy Conservation Code Of New York State.

MECHANICAL VENTILATION: The building shall be provided with ventilation that meets the requirements of the 2020 Residential Code or 2020 Mechanical Code Of New York State, as applicable, or with other approved means of ventilation. Outdoor air intakes and exhausts shall have automatic or gravity dampers that close when the ventilation system is not operating. See Section R403.6 Of the 2020 Energy Conservation Code Of New York State For More Detail.

# Site Work:

SITE WORK: Provide 2" blacktop driveway, 4" gravel base to street. Sidewalks to be 3' wide, 4" concrete or I I/2" flagstone laid in sand, from house to driveway. Provide top soil and seed to all areas disturbed by construction.

# Insulation / Energy Code:

Refer to "RES CHECK" energy study attached to plans or fixed to first page.

INSULATION: Shall be fiberglass batt with foil faced vapor barrier, "R" value stated on attached RES-CHECK.

Pack insulation in all cavities around all exterior windows, doors and other openings.

AIR LEAKAGE: Joints, penetrations, and all other such openings in the building envelope that are sources of air leakage must be sealed in accordance with the requirements of Sections R402.4.1 through R402.4.4. Of the 2020 Energy Conservation Code Of New York State. Recessed lights must be 1) Type IC rated, or 2) installed inside an appropriate air-tight assembly with a 0.5" clearance from combustible materials. If non-IC rated, the fixture must be installed with a 3" clearance from insulation.

VAPOR RETARDER: Required on the warm-in-winter side of all non-vented framed ceilings, walls, and floors.

#### Material Identification:

Materials and equipment must be installed in accordance with the manufacturer's installation instructions.

Materials and equipment must be identified so that compliance can be determined.

Manufacturer manuals for all installed heating and cooling equipment and service water heating equipment must be provided. Insulation R-values and glazing U-factors must be clearly marked on the building plans or specifications.

#### Duct Insulation:

Supply and return ducts in attics shall be insulated to an R-value of not less than R-8 for ducts 3 inches (76 mm) in diameter and larger and not less than R-6 for ducts smaller than 3 inches (76 mm) in diameter.

Supply and return ducts in other portions of the building shall be insulated to not less than R-6 for ducts 3 inches (76 mm) in diameter and to not less than R-4.2 for ducts smaller than 3 inches (76.2 mm) in diameter. Exception being ducts located in conditioned spaces. See 2020 Residence Code Of New York State.

Ducts buried within ceiling insulation both supply and return shall have an insulation R-value not less than R-8. At all points along each duct, the sum of the ceiling insulation R-values against and above the top of the duct, and against and below the bottom of the duct shall be not less than R-19, excluding the R-value of the duct insulation.

### Duct Construction:

All joints, seams, and connections must be securely fastened with welds, gaskets, mastics (adhesives), masticplus-embedded-fabric, or tapes. Duct tape is not permitted.

- Exception: Continuously welded and locking-type longitudinal joints and seams on ducts operating at less than 2 in. W.q. (500 Pa).
- Exception: Air-impermeable spray foam products shall be permitted to be applied without additional joint seals.

  Ducts shall be supported every 10 feet or in accordance

with the manufacturer's instructions.

Cooling ducts with exterior insulation must be covered with

a vapor retarder.

Air filters are required in the return air system.

The HVAC system must provide a means for balancing air and water systems.

#### Temperature Controls:

Each dwelling unit has at least one thermostat capable of automatically adjusting the space temperature set point of the largest zone.

#### Electrical Systems:

Separate electric meters are required for each dwelling unit.

#### Fireplaces:

Fireplaces must be installed with tight fitting noncombustible fireplace doors. Fireplaces must be provided with a source of combustion air, as required by the Fireplace construction provisions of the Building Code, the Residential Code as applicable.

## Service Water Heating:

Water heaters with vertical pipe risers must have a heat trap on both the inlet and outlet unless the water heater has an integral heat trap or is part of a circulating system.

### Swimming Pools:

All heated swimming pools must have an on/off heater switch and require a cover unless over 20% of the heating energy is from non-depletable sources. Pool pumps require a time clock.

# Heating & Cooling Piping Insulation:

Mechanical system piping capable of carrying fluids above 105 degrees F or chilled fluids below 55 degrees F must be insulated to a Minimum of R-3. See Section R403.4 of the 2020 Energy Conservation Code Of New York State for more detail.

4 NEW YORK U 0 <u>;</u> K15C0, O 4 MOUNT AVENUE, S  $\Sigma_{Q}$ SMITH 0 (414) ofervien Drive 9 Residen Revision Date Date July 22, 2020 Job No 22*0-0*II Drawing





